


28.1.98

1.1. May 8668.


Sketch of Deep Water Ballast Tank.

S.S. No 103.



Scale $\frac{1}{4}'' = 1$ Foot.

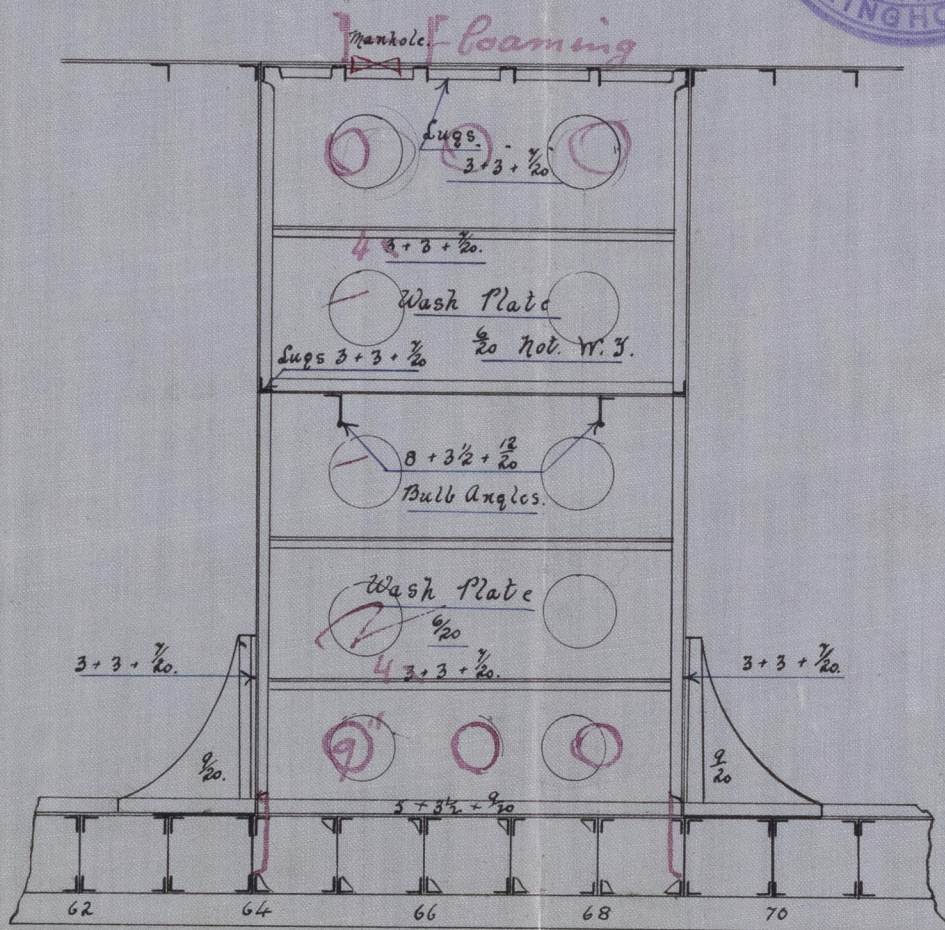

Elevation Through Centre.

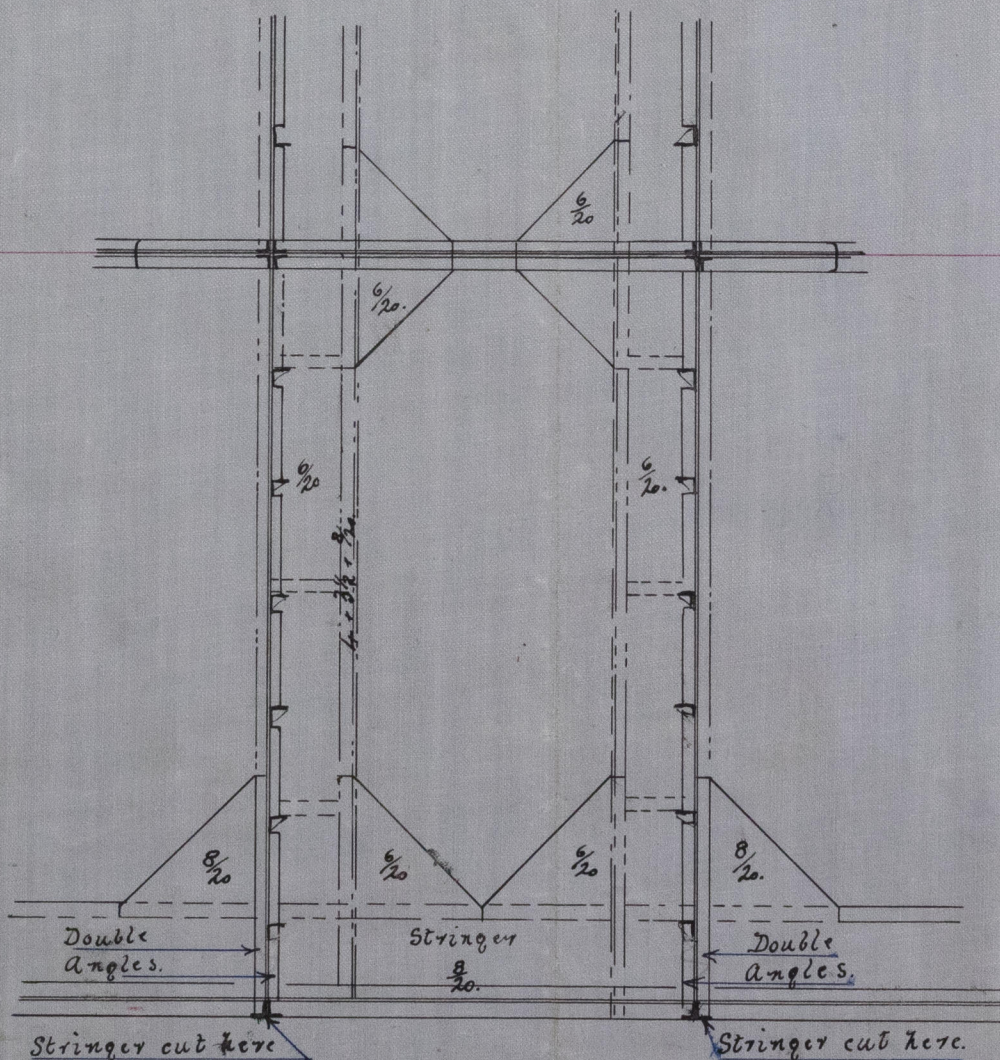

Plan in Way of Hold Beams.

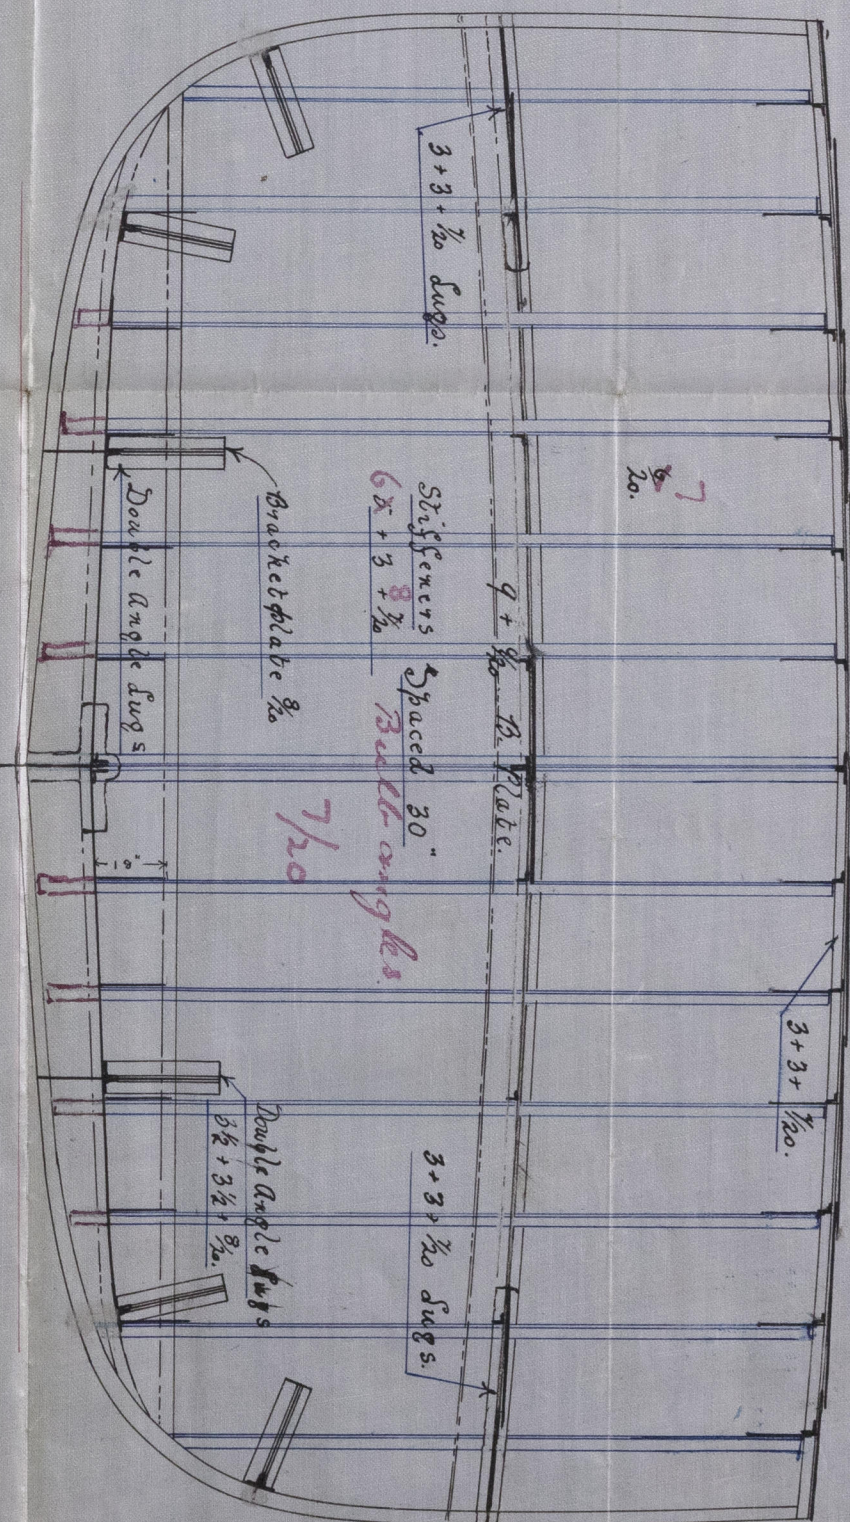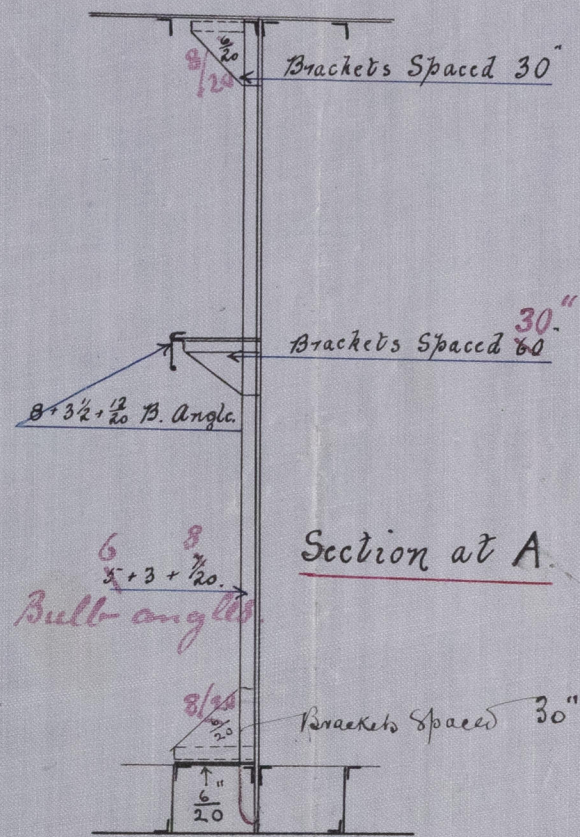

W. J. B. 8668 69.
Looking forward.

meurs. J. Scott & Co?

S. S. № 103

"May"

Lth. Rept. No 8668



LT 4568-0014

© 2019

Lloyd's Register
Foundation