

Lloyd's Register of British and Foreign Shipping.

(Report on Vessel No. 8901 Port Leith)

Leith

No. 3793 a

SHIP FORGINGS OR CASTINGS.

I have to report that the undermentioned Iron or Steel Forgings or Castings, manufactured by The Darlington Forge Co. of Darlington for the Vessel No. 161, being built by Messrs Ramsay & Ferguson of Leith have been inspected by me as set forth below, and found to be, so far as can be seen, sound

Mark on Forgings.

Lloyd's


No. _____

Wm Cameron


Sundaland
15. 9. 98

	STERN FRAME.	RUDDER FRAME.	STEM.
Material*	<u>Scrap</u>	<u>Scrap</u>	<u>Scrap</u>
How made	<u>Forged</u>	<u>Forged</u>	<u>Forged</u>
Dimensions	<u>7 1/2 x 4 3/4</u>	<u>as for framing attached</u>	<u>7 1/4 x 2 3/8</u>
Progress on Inspection	<u>Forged & Smithed</u>	<u>Forged & Machined</u>	<u>Forged</u>
Date when Inspected	<u>March 14th & May 27/98</u>	<u>June 8th & Aug 29/98</u>	<u>April 22/98</u>

SKETCHES OF FRAMES SHOWING POSITION AND DESCRIPTION OF WELDS OF FORGINGS, OR PARTICULARS OF TESTS APPLIED TO CASTINGS.

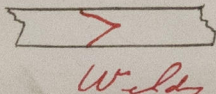

Welds

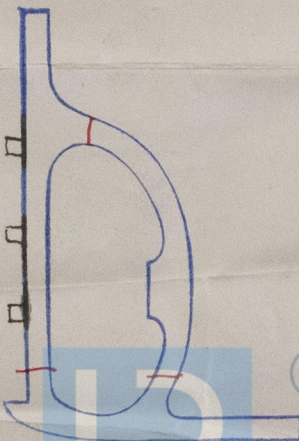

Fee (if any chargeable) £ : :

To be paid at _____

* If of Iron, state whether scrap or puddled Iron.


"Sifka"

Rech. Repert. № 8901



© 2019

Lloyd's Register
Foundation