


Meun. Ramadex Ferguson (Linn)

S. S. No 164 & 165
now Henriette

N^o: 164 "Aurora" Lth. Regt. N^o: 9027

N^o 165 "Arce.
Sept 10: 9028

LTH 568-0102

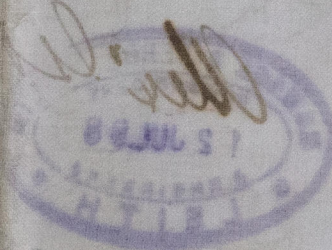

14.7.98
27.7.98

N:164 "Aurora" Lm. Regt. No.

N:165 "Aries" Lm. Regt. No.

MIDSHIP SECTION


SCREW STEAM TRAWLERS N^{OS} 164-165

DIMENSIONS 105'0" BP x 20'4 1/2" MT x 11'0" MT

SCALE 3/4" = 1 FOOT

TO CLASS 100 A.I. AT LLOYDS
(TRAWLER)

Wm. L. Ramey
12 JUL 98
9cms

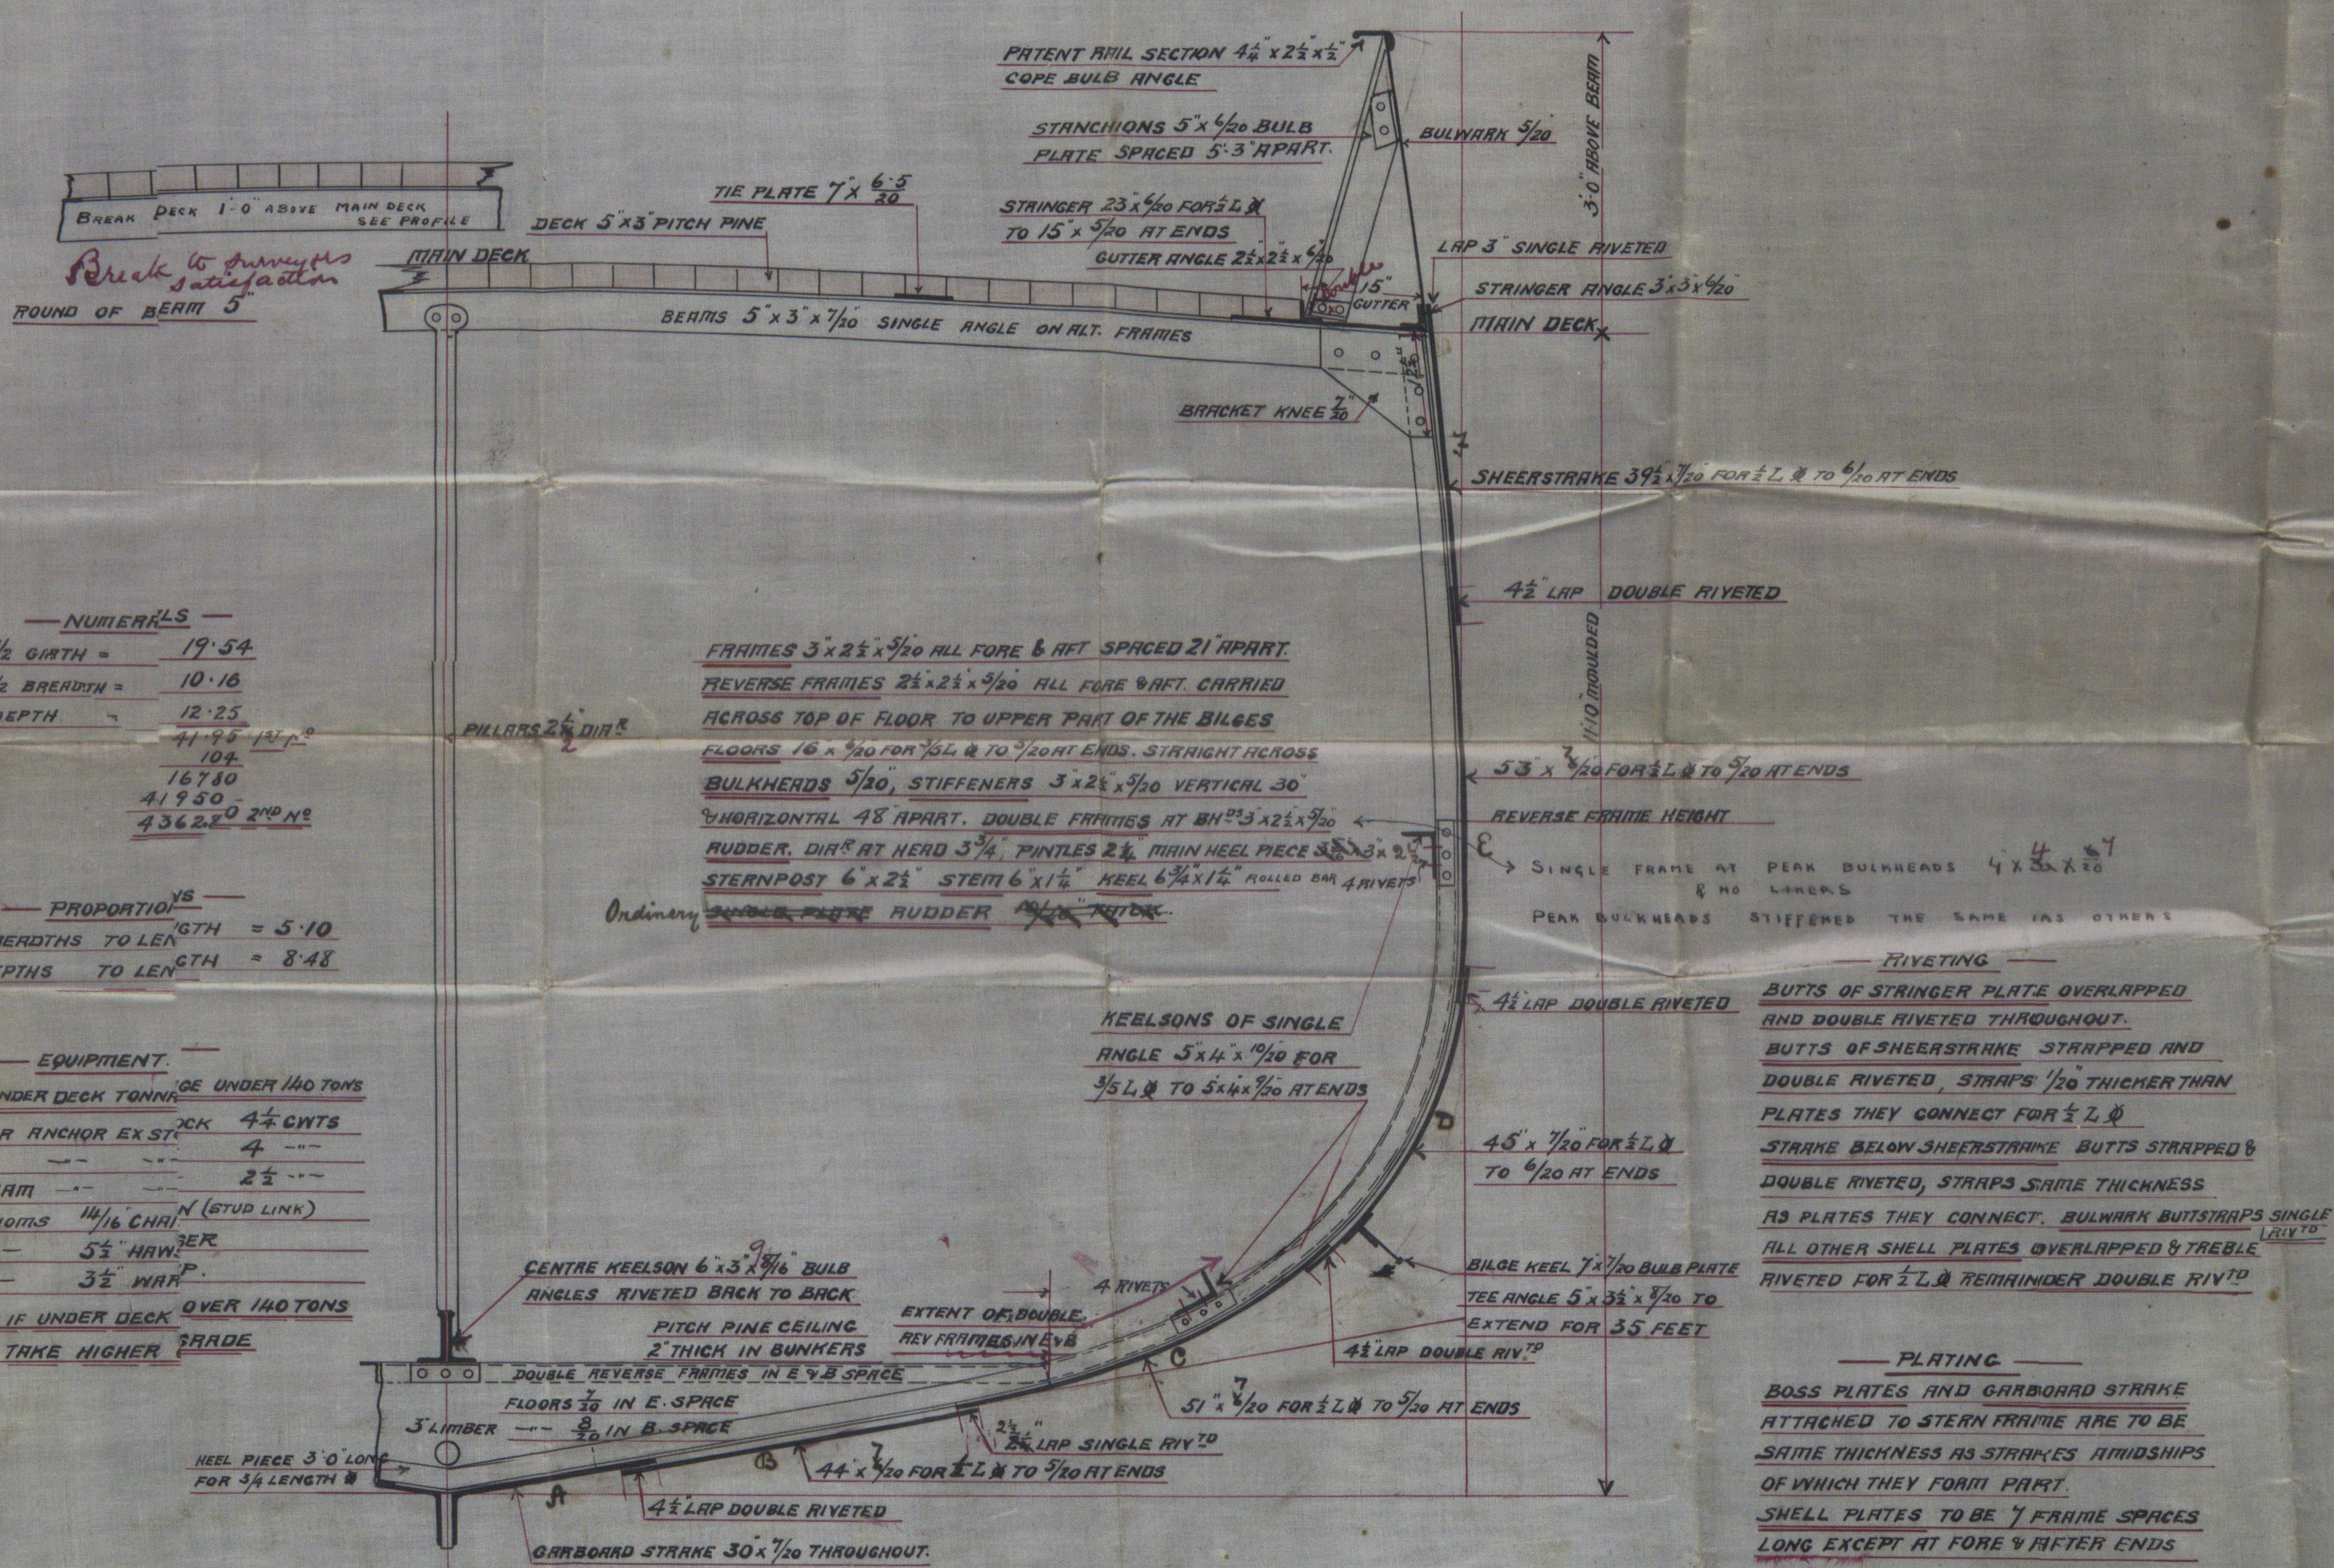

W.L.R.
14/7/98

134 JUL 98