




Profile

Messrs. Ramsay & Ferguson (Lim<sup>d</sup>)

S. S. Nos 164 & 165

N<sup>o</sup> 164 "Aurora" Rept. N<sup>o</sup> 9027

N<sup>o</sup> 165 "Aries" Report N<sup>o</sup> 9028

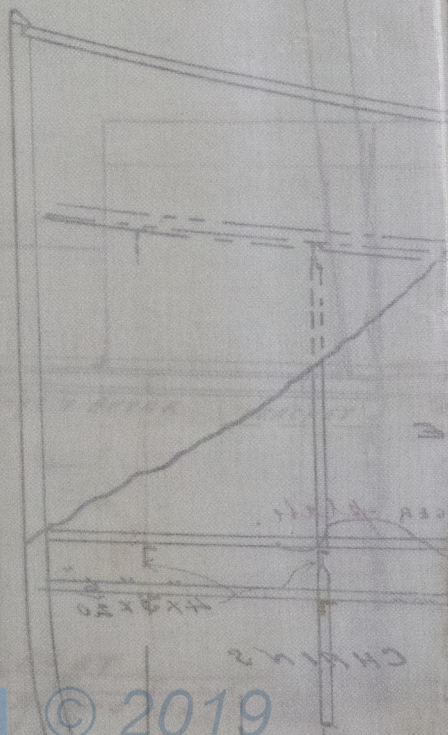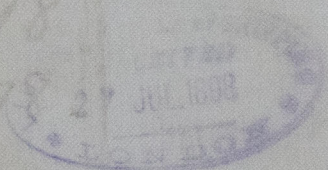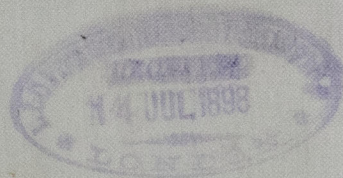

© 2019


Lloyd's Register  
Foundation

LTH 568-0103



N<sup>o</sup> 165 "Aries" Lth. Dept. N<sup>o</sup> 9028

14. 7. 98  
27. 7. 98

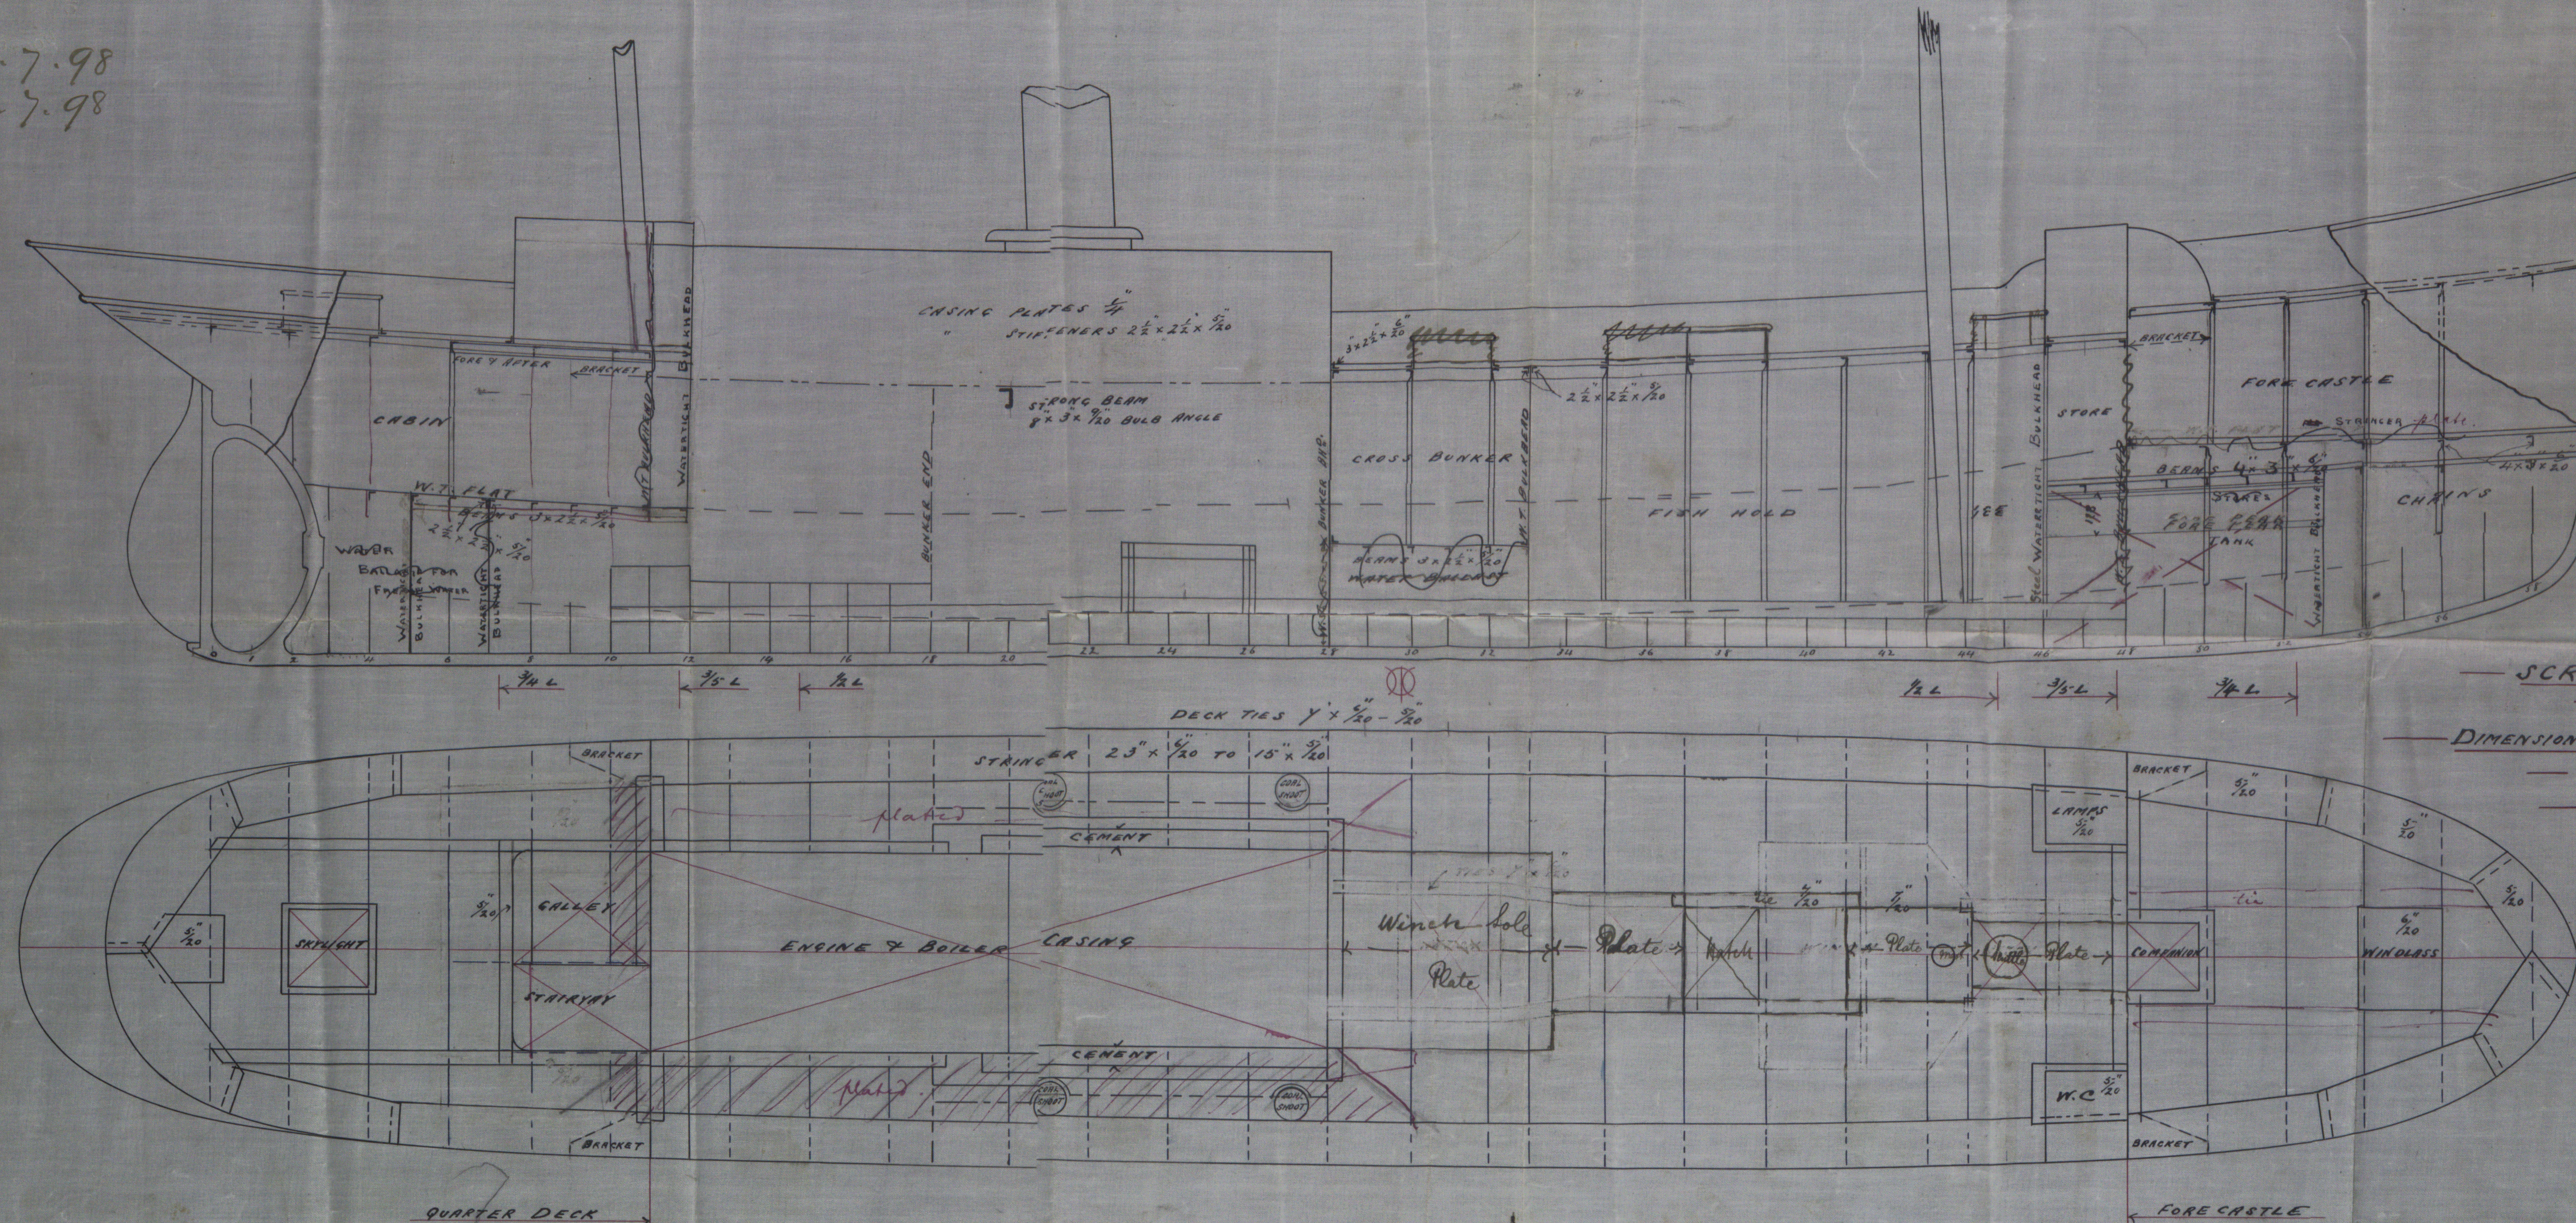

SCREW STEAM TRAWLERS

N<sup>os.</sup> 164 & 5

DIMENSIONS 105' B.P. x 20' 4 1/2" M.D. x 11' 10" M.D.

CLASS 100 A.I. AT LLOYDS

SCALE  $\frac{1}{4}'' = 1 \text{ FOOT}$

12 JUL 98  
LEITH  
GMS

13<sup>th</sup> July '98.  
W.I.