


Pumping Plan
Messrs. Ramsay & Ferguson (Lim^d)

I.I. No 164 x 165

No 164 "Aurora" Rept. No 9027

No 165 "Aries" Rept. No 9028

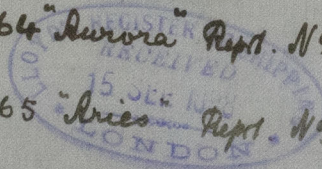

LTH 568-0105




© 2019

Lloyd's Register
Foundation

(Print) name of vessel, number
 2318 164 512
 1509 164 512
 8009 164 512

16:9:98.
 16:9:98.

№ 164 "Aurora" Lth. Regt. № 9027
 № 165 "Aries" Lth. Regt. № 9028

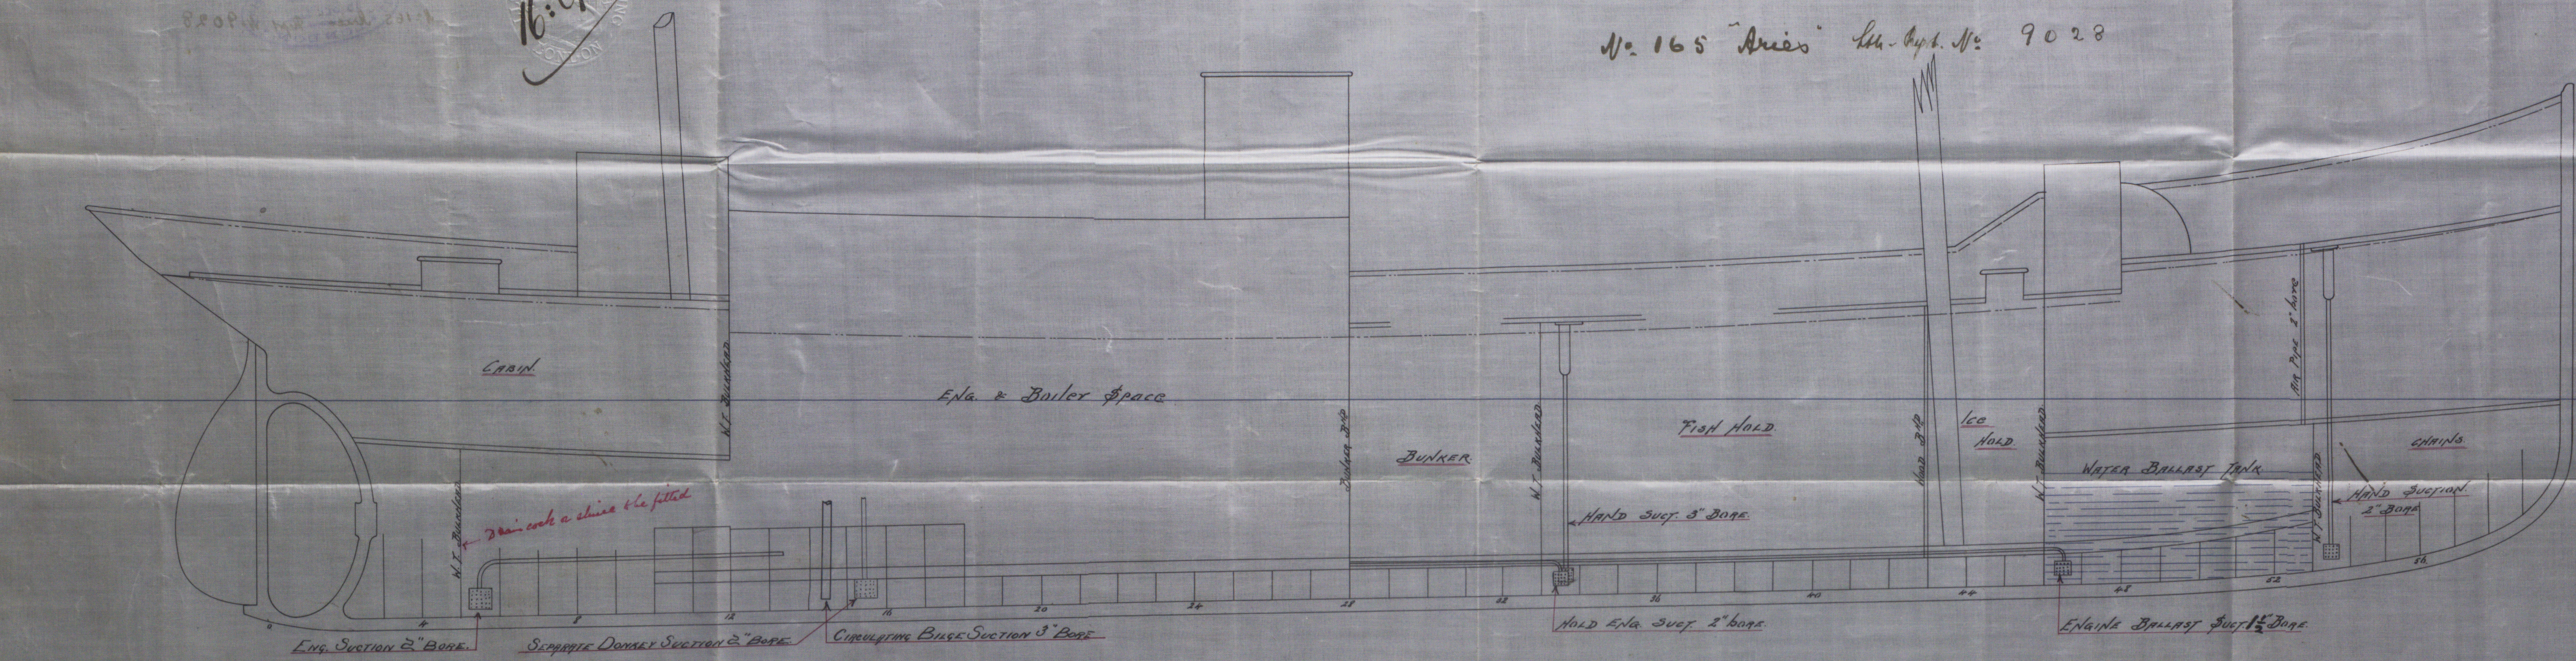

— Plan showing suction —
 — & Trawlers № 164.5 —
 — 1/4" = 1 ft. —

Under D.R. Tonnage under 500 tons

14:9:98
 15:9:98
 14/9/98