


S/S 'Cairntaker'

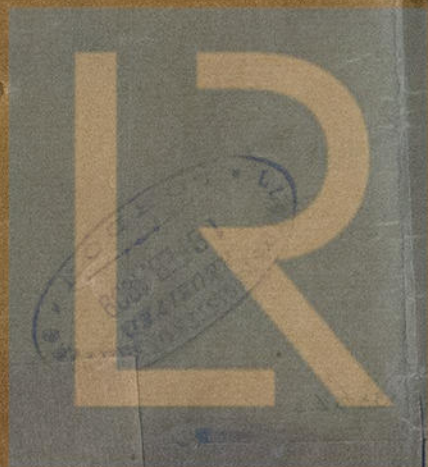

© 2019

Lloyd's Register  
Foundation

LTH569-0337



S.S. "CAIRNBATH"

redrawn 2/8

13.2.09  
18.2.09

SECTION C SHOWING PROPOSED ALTERATION

AT AFTER END OF N°3 HATCH ~~4 c/o 4 Hatch~~

SCALE 1/2" = 1 FOOT

Quarter Deck



© 2019

Lloyd's Register Foundation