

LTH569-0338

S/S Cairnholm

1500 2 1/2 x 3 1/2




19

's Register
dation

S.S. "CAIRNBARN" EX S.S. "TREVIDER"

PROFILE, SHOWING PRESENT ARRANGEMENT OF
PARTIAL BULKHEADS AND HOLD BEAMS.

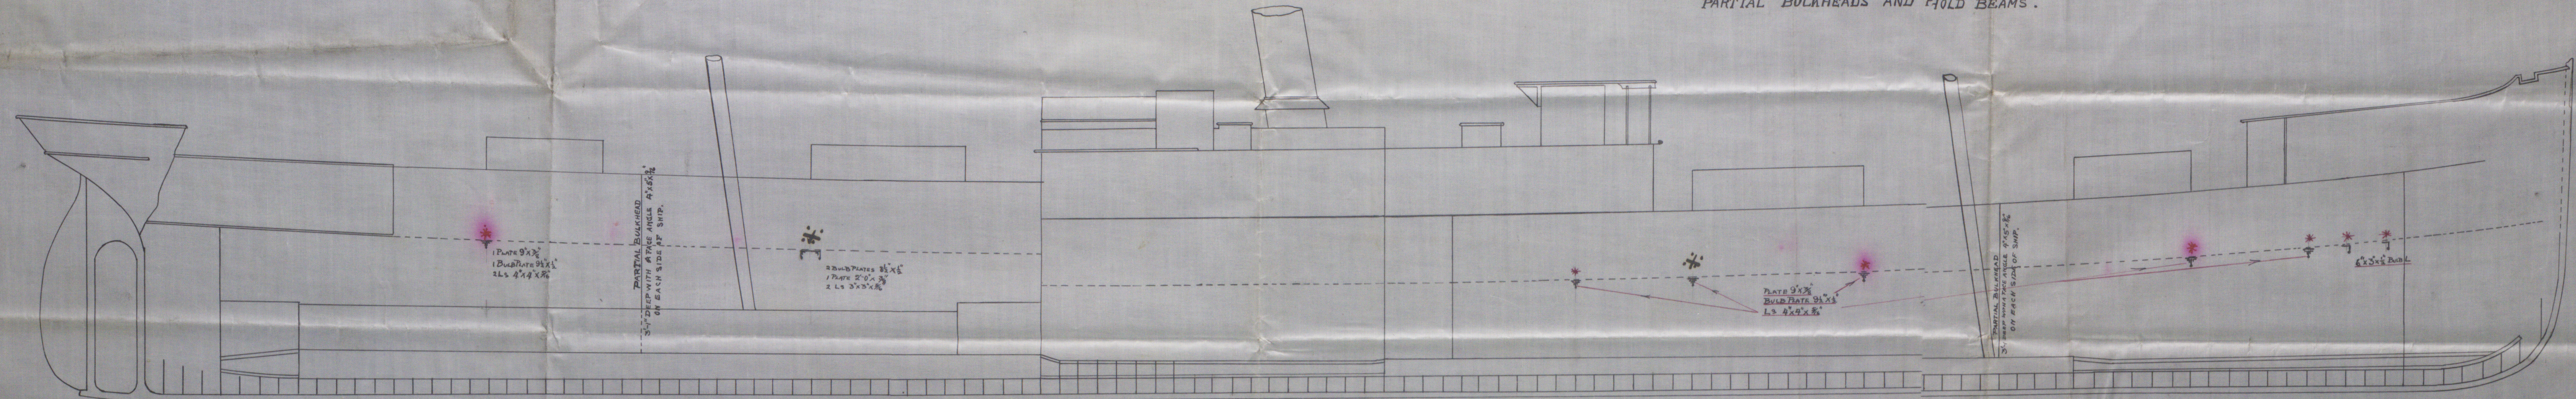

* Beams marked thus now cut out
and web frames fitted

* NOTE:— THESE BEAMS TO REMAIN AS BEFORE.

LTH569-0332