



# PROPOSED STRENGTHENING AT BREAK OF QUARTER DECK

— "N<sup>o</sup> 308" —

*See Ltr to Hpl.*  
THU 28 NOV 89

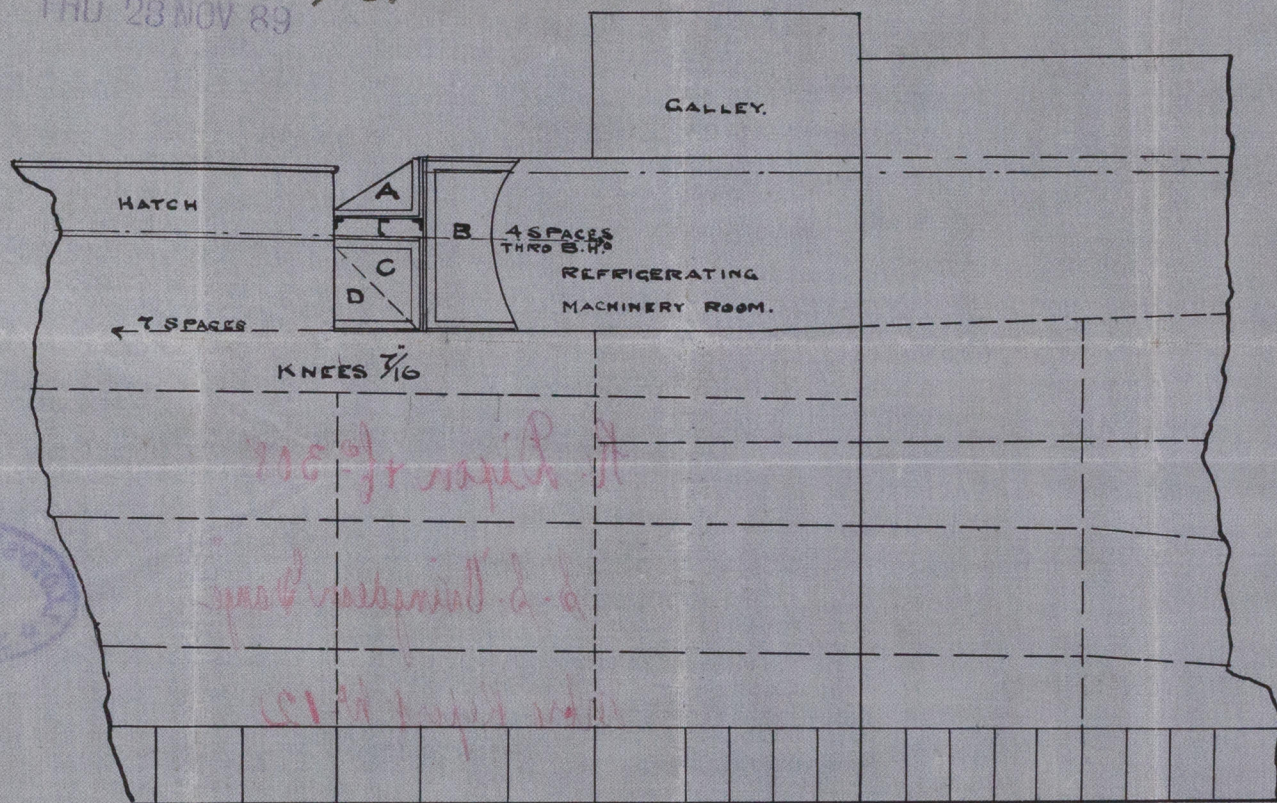

DOUBLE ANGLES AT TOP & BOTTOM OF BRACKETS &c.

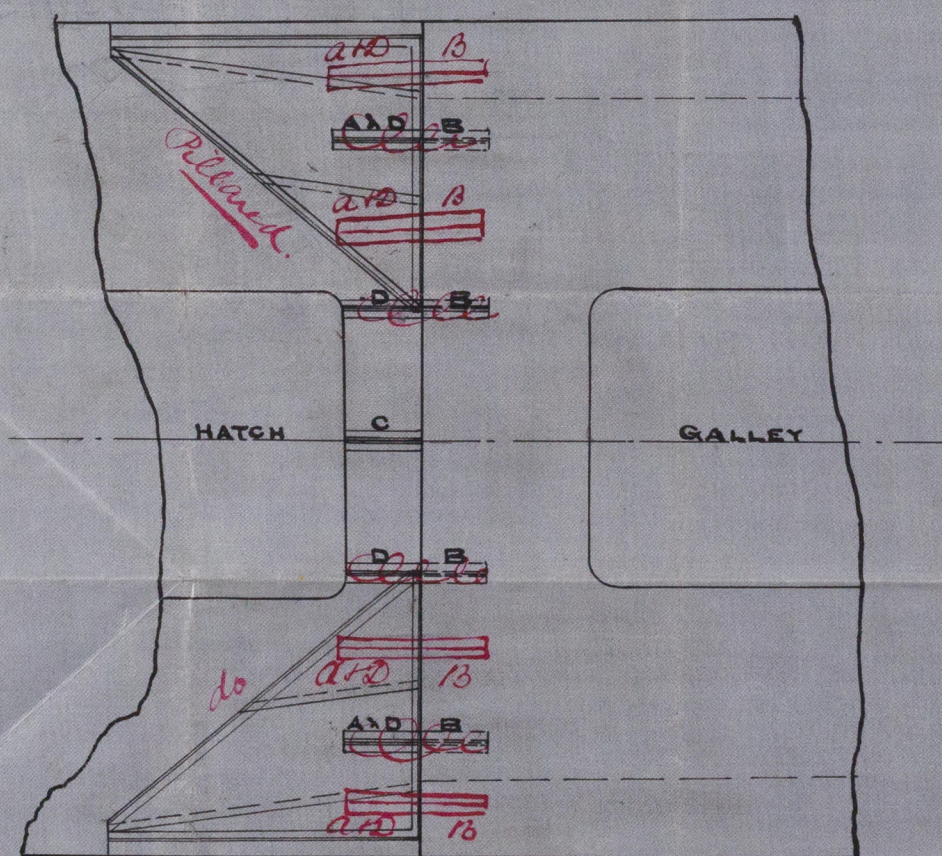

28/11/89




28.11.89  
27.11.89

Lloyd's Register  
Foundation

MD3739H3



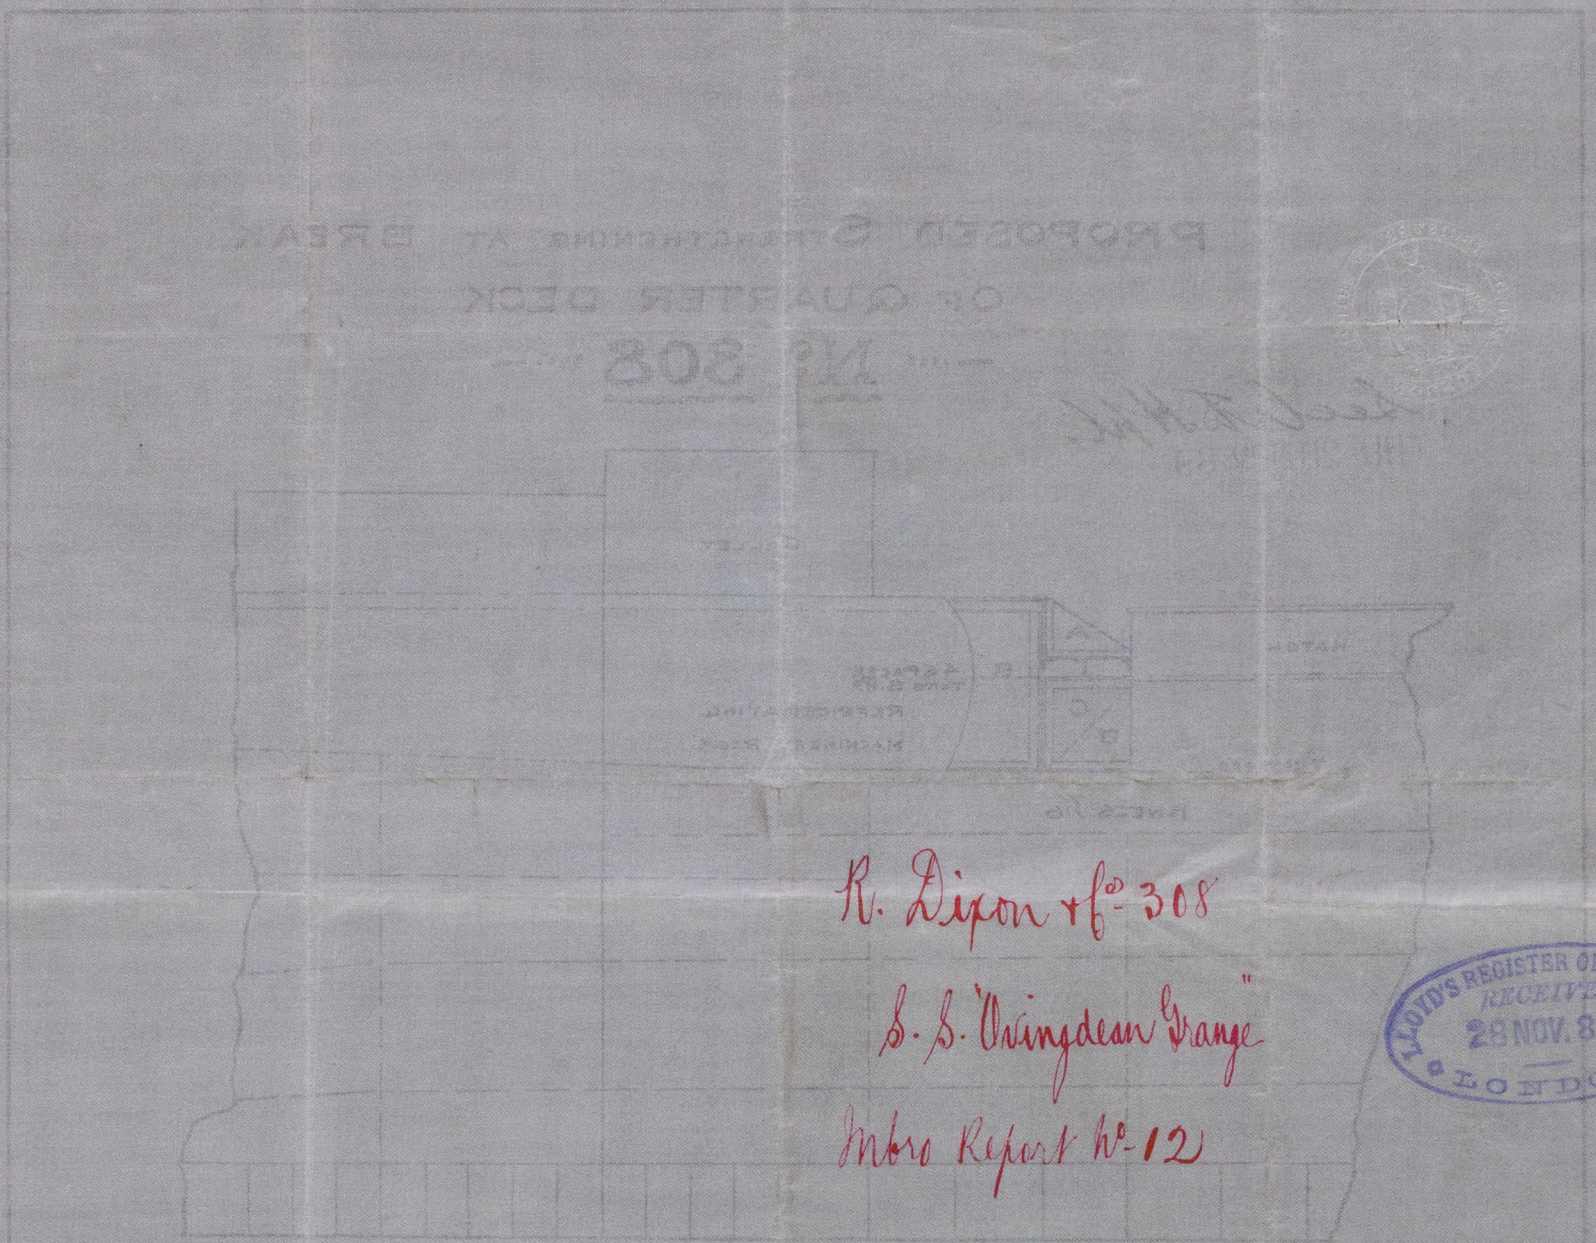



R. Dixon + Co 308

S. S. 'Oringdean Grange'

Intro Report No 12



MDB739/13

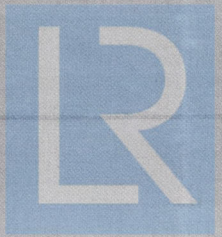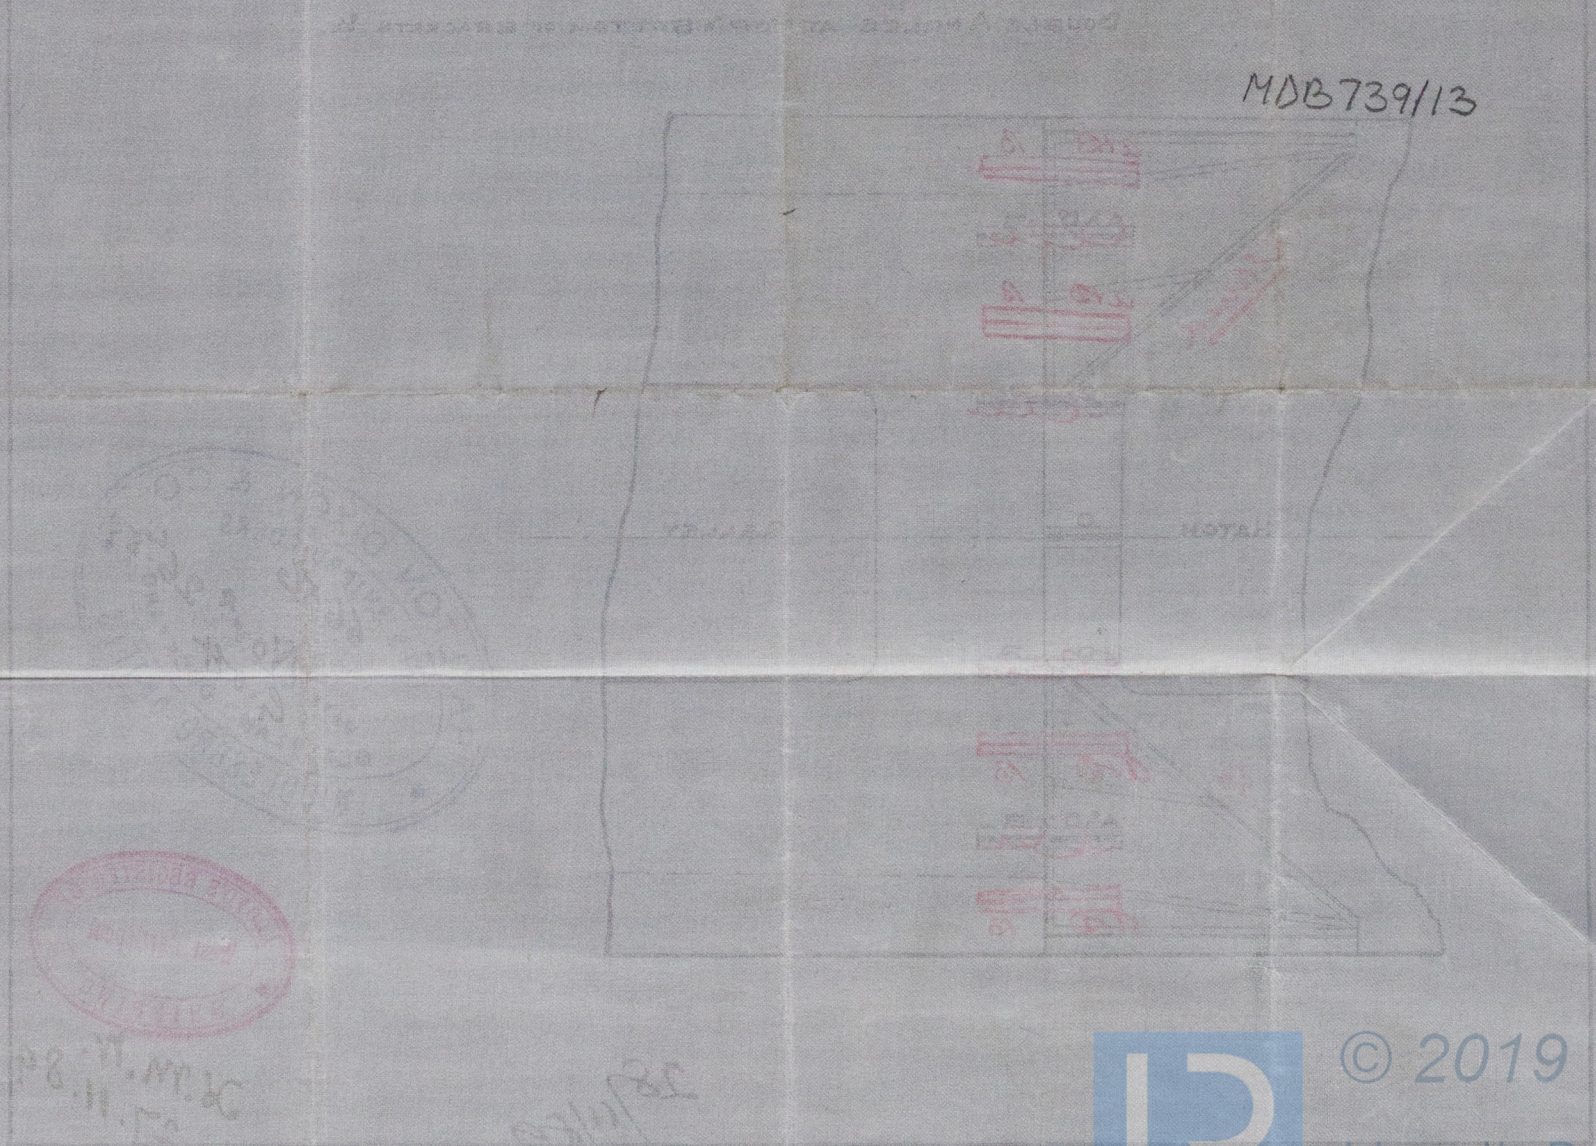

© 2019

Lloyd's Register  
Foundation