

S. S. "Oringdean Grange"

Received at West Hartlepool Office, Nov 6 1889

Lloyd's Register of British and Foreign Shipping.

Wpool

(Report on Vessel No. 12

Port

Middlebrough
West Hartlepool

No. 1419A

SHIP FORGINGS OR CASTINGS.

I have to report that the undermentioned Iron or Steel Forgings or Castings, manufactured by

Messrs J Richardson & Son of Warrington

for the Vessel No. 308, being built by Messrs R Dixon & Co.

of Middlebrough have been inspected by me as set forth below, and found to be, so far as can be seen, sound.

Mark on Forgings.

Lloyd's

No. 1419A



W.C.

W. Cameron

London 5/6/89

	STERN FRAME.	RUDDER FRAME.	STEM.
Material* - - - -	<u>Scrap iron</u>	<u>Scrap iron</u>	
How made - - - -	<u>Forged</u>	<u>Forged</u>	
Dimensions - - - -	<u>10' x 6'</u>	<u>7 1/4' - 3 3/4'</u>	
Progress on Inspection -	<u>Smithed</u>	<u>Forged & Smithed</u>	<u>Not seen</u>
Dates when Inspected	<u>June 5-18-29/89</u>	<u>Aug 30 Oct 7-16/89</u>	

SKETCHES OF FRAMES SHEWING POSITION AND DESCRIPTION OF WELDS OF FORGINGS, OR PARTICULARS OF TESTS APPLIED TO CASTINGS.

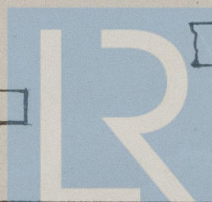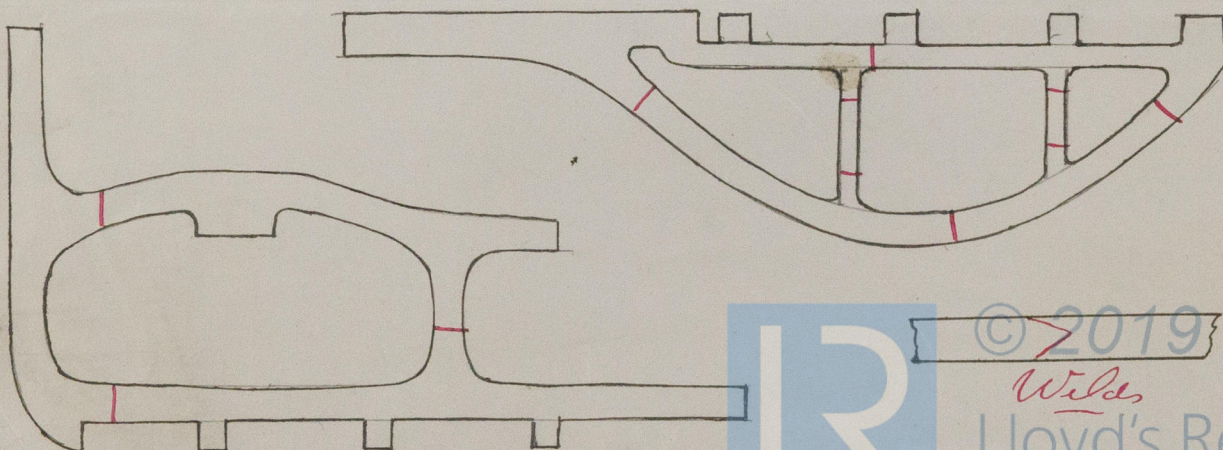

© 2019

Wills

Lloyd's Register
Foundation



© 2019

Lloyd's Register
Foundation