

S.S. "Bona"

Received at West Hartlepool Office, 12th Dec 1889

Lloyd's Register of British and Foreign Shipping.

Wpool

(Report on Vessel No. 13

Port ~~West Hartlepool~~ Middlesbrough

No. 1460A.

SHIP FORGINGS OR CASTINGS.

The words FORGINGS or CASTINGS, IRON or STEEL, should be struck out as may be required.

I have to report that the undermentioned Iron or Steel Forgings or Castings, manufactured by

Messrs J Richardson Sons of Hartlepool for the Vessel No. 311, being built by Messrs R Dixon Co. of Middlesbrough have been inspected by me as set forth below, and found to be, so far as can be seen, sound


Mark on Forgings.

Lloyd's No. 1460A R.C.


Wm Cameron Sunderland 10/12/89

Table with 4 columns: Material*, How made, Dimensions, Progress on Inspection, Dates when Inspected. Rows for STERN FRAME, RUDDER FRAME, and STEM.

SKETCHES OF FRAMES SHEWING POSITION AND DESCRIPTION OF WELDS OF FORGINGS, OR PARTICULARS OF TESTS APPLIED TO CASTINGS.

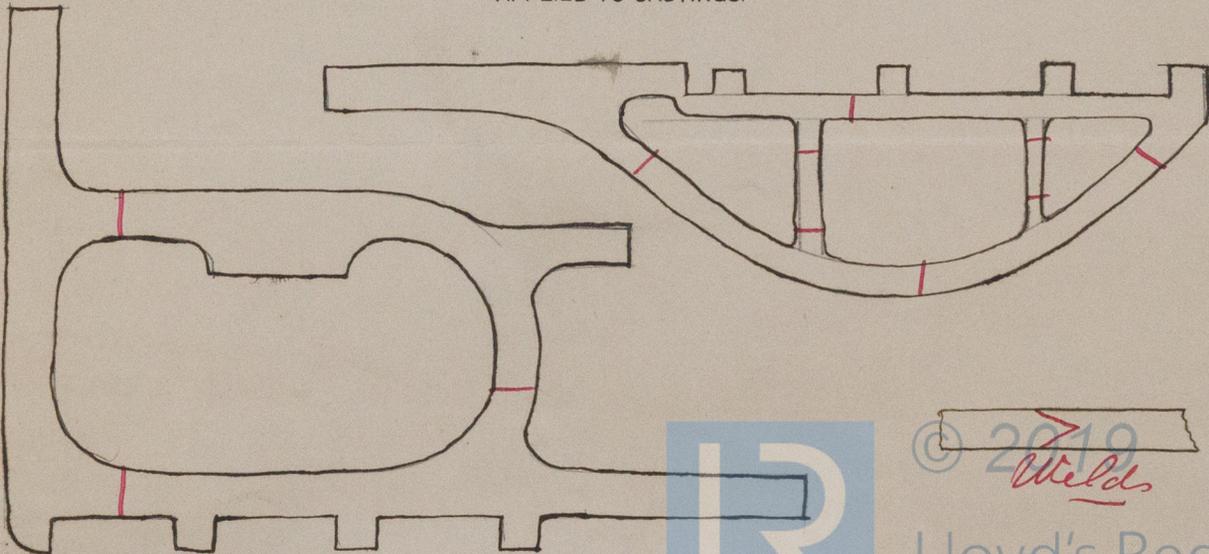

© 2019 Welds

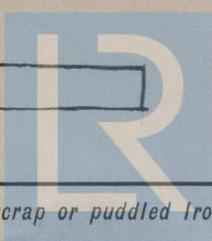

Lloyd's Register Foundation

* If of Iron, state whether scrap or puddled iron.

SHIP FORGINGS OR CASTINGS



© 2019

Lloyd's Register
Foundation