

S.S. America

Received at West Hartlepool Office, 11th Jan 1890

Lloyd's Register of British and Foreign Shipping.

W. Pool

(Report on Vessel No. 18)

Port *West Hartlepool*

No. 1525a

SHIP FORGINGS OR CASTINGS.

The words FORGINGS or CASTINGS, IRON or STEEL, should be struck out as may be required.

I have to report that the undermentioned Iron or Steel Forgings or Castings, manufactured by *Imp^r J Richardson & Son* of *Northpool* for the Vessel No. *312*, being built by *Imp^r R Nixon & Co.* of *Middlesbrough* have been inspected by me as set forth below, and found to be, so far as can be seen, *sound.*


Mark on Forgings.

Lloyd's
No 1525a
R.C.

W. Cameron
Sunderland

	STERN FRAME.	RUDDER FRAME.	STEM.
Material* - - - -	<i>Scrap iron</i>	<i>Scrap iron</i>	
How made - - - -	<i>Forged</i>	<i>Forged</i>	
Dimensions - - - -	<i>7" x 4 1/2"</i>	<i>4 3/4" - 2 3/4"</i>	
Progress on Inspection -	<i>Finished</i>	<i>Finished</i>	<i>not seen</i>
Dates when Inspected	<i>Oct 19 Nov 4/89</i>	<i>Nov 27 Dec 9-14/89</i>	

SKETCHES OF FRAMES SHEWING POSITION AND DESCRIPTION OF WELDS OF FORGINGS, OR PARTICULARS OF TESTS APPLIED TO CASTINGS.

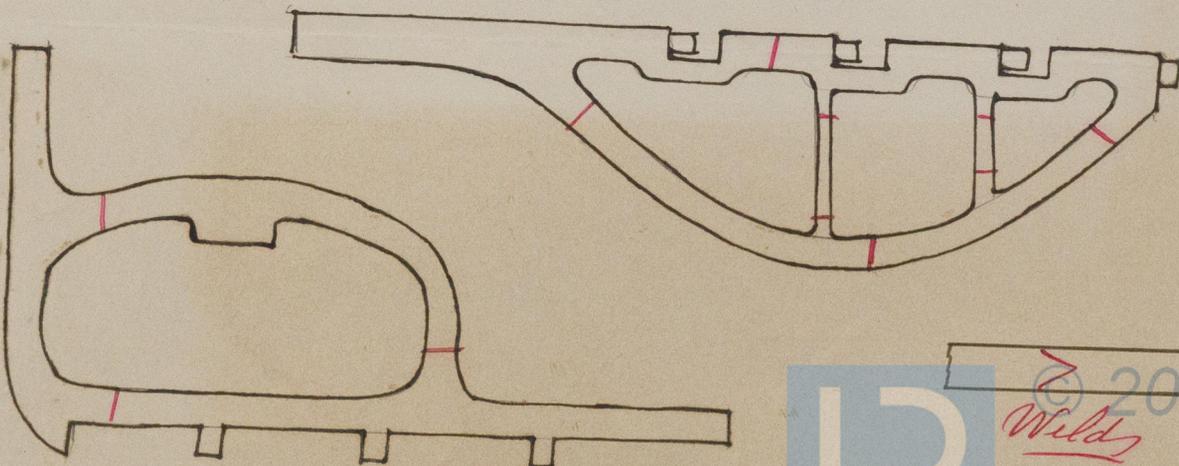










© 2019

Lloyd's Register
Foundation