




THU 12 SEP 89
SAT 28 SEP 89

*comp'd. d.d.
see ref. in 10
101.88 water level of*

PROFILE S.S. 121 SHEWING WELL FILLED IN

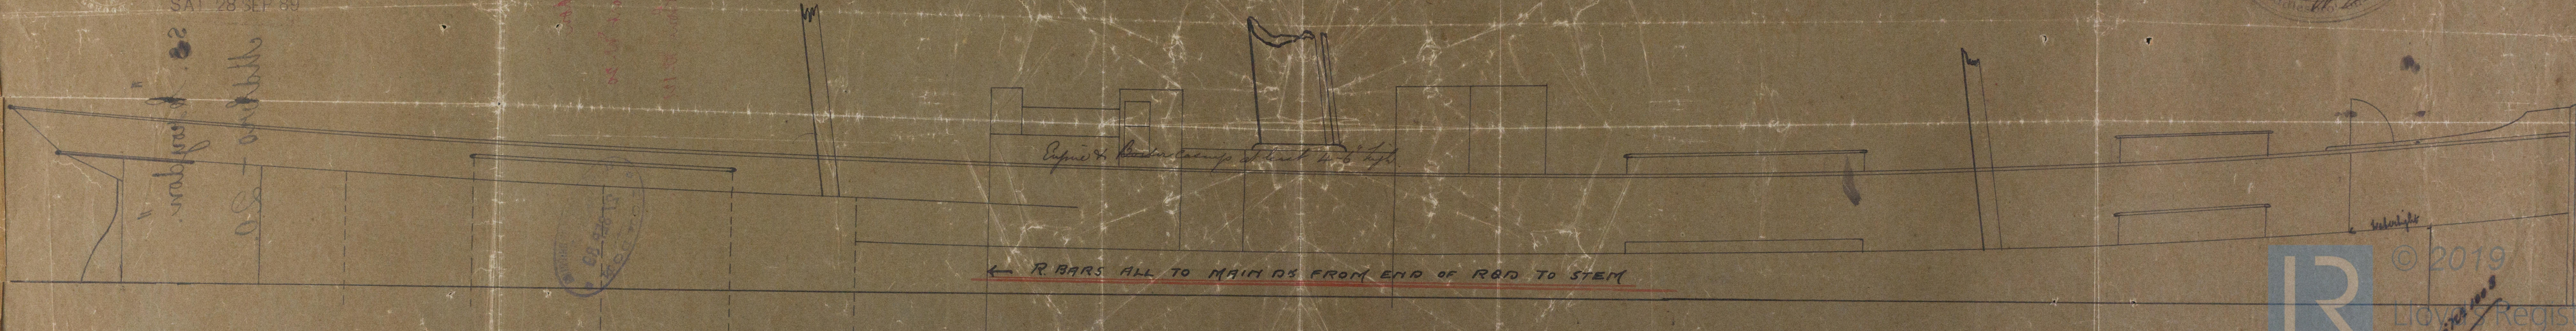

© 2019

Lloyd's Register
Foundation


MDB739/60

ss. ¹¹ *Greydon* ¹¹

Adbro - 20

S. S. Croxson

Intro Report No. 20

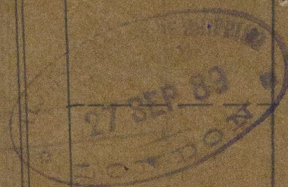

MD5739/60




