

S. S. Croxson

Received at West Hartlepool Office, 11<sup>th</sup> Jan 1890

# Lloyd's Register of British and Foreign Shipping.

(Report on Vessel No. 20

Port *Middlesbro*  
*West Hartlepool*)

*Opool*

No. 1409A

## SHIP FORGINGS OR CASTINGS.

I have to report that the undermentioned Iron or Steel Forgings or Castings, manufactured by

*The Iron Forge Co.*

of *Gallion*

for the Vessel No. *121*, being built by *Messrs. H. Warkentin Son*

of *Middlesbro*

have been inspected by me *W. Lunny* as set forth below, and found

to be, so far as can be seen, *sound.*

The words FORGINGS or CASTINGS, IRON or STEEL, should be struck out as may be required.

Mark on Forgings.

Lloyd's

No. 1409A


*W.C.*

*W. Lunny*

*Sunderland*

	STERN FRAME.	RUDDER FRAME.	STEM.
Material*	<i>Scrap iron</i>	<i>Scrap iron</i>	
How made	<i>Forged</i>	<i>Forged</i>	
Dimensions	<i>7 1/4 x 4 3/4</i>	<i>5 1/2 - 3"</i>	
Progress on Inspection	<i>Forged &amp; milled</i>	<i>Forged &amp; milled</i>	<i>Not seen</i>
Dates when Inspected	<i>July 20 Sept 20/89</i>	<i>Nov 6-13-19-23-24 Dec 5-10-18/89</i>	

SKETCHES OF FRAMES SHEWING POSITION AND DESCRIPTION OF WELDS OF FORGINGS, OR PARTICULARS OF TESTS APPLIED TO CASTINGS.

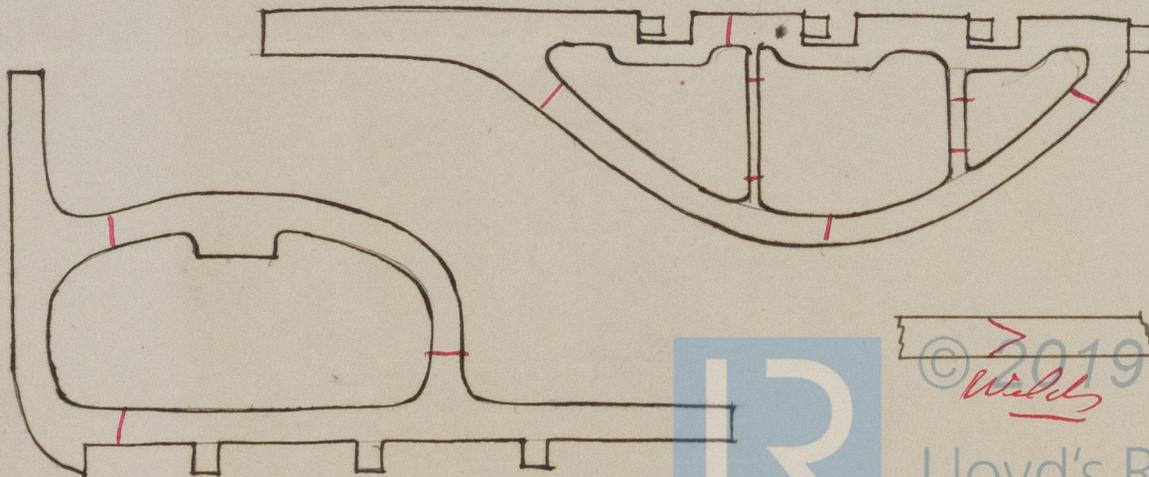

\* If of Iron, state whether scrap or puddled Iron.







 

© 2019

Lloyd's Register  
Foundation

MOR739/61