

(Copy)

To be placed with  
first entry report on  
S.S. "Blanchbury"  
Office, 189

## Lloyd's Register of British and Foreign Shipping.

(Report on Vessel No. \_\_\_\_\_ Port \_\_\_\_\_)

No. 220

## SHIP FORGINGS OR CASTINGS.

I have to report that the undermentioned Iron or Steel Forgings or Castings,  
manufactured by *The Sarnon Forge Company*,  
of *Sarnon* for the Vessel No. *19*, being built  
by *Messrs Craig, Taylor & Co.* of *Stockton*  
have been inspected by me as set forth below, and found to be, so far as can be seen,  
*Sound.*

Mark on Forgings.


Lloyd's  
No. 62 B  
J.C.

(Signed) *John C. Craig*  
*Newcastle*

24.3.90  
STEM.

	STERN FRAME.	RUDDER FRAME.	STEM.
Material* ...	<i>Scrap iron</i>	<i>Scrap iron</i>	<i>Scrap iron</i>
How made ...	<i>Forged</i>	<i>Forged</i>	<i>Forged</i>
Dimensions ...	<i>9 - 5½</i>	<i>7 - 3½</i>	<i>9 - 2½</i>
Progress on Inspection	<i>Forged &amp; Smithed</i>	<i>Forged &amp; Smithed</i>	<i>Finished</i>
Date when Inspected	<i>Oct. 23. 29</i> <i>November 5. 8. 13/89</i>	<i>January 8. 13. 16. 21. 27</i> <i>Feb. 18. 21. March 3. 6. 11/90</i>	<i>November 23/89</i>

SKETCHES OF FRAMES SHOWING POSITION AND DESCRIPTION OF WELDS OF FORGINGS, OR PARTICULARS OF  
TESTS APPLIED TO CASTINGS.

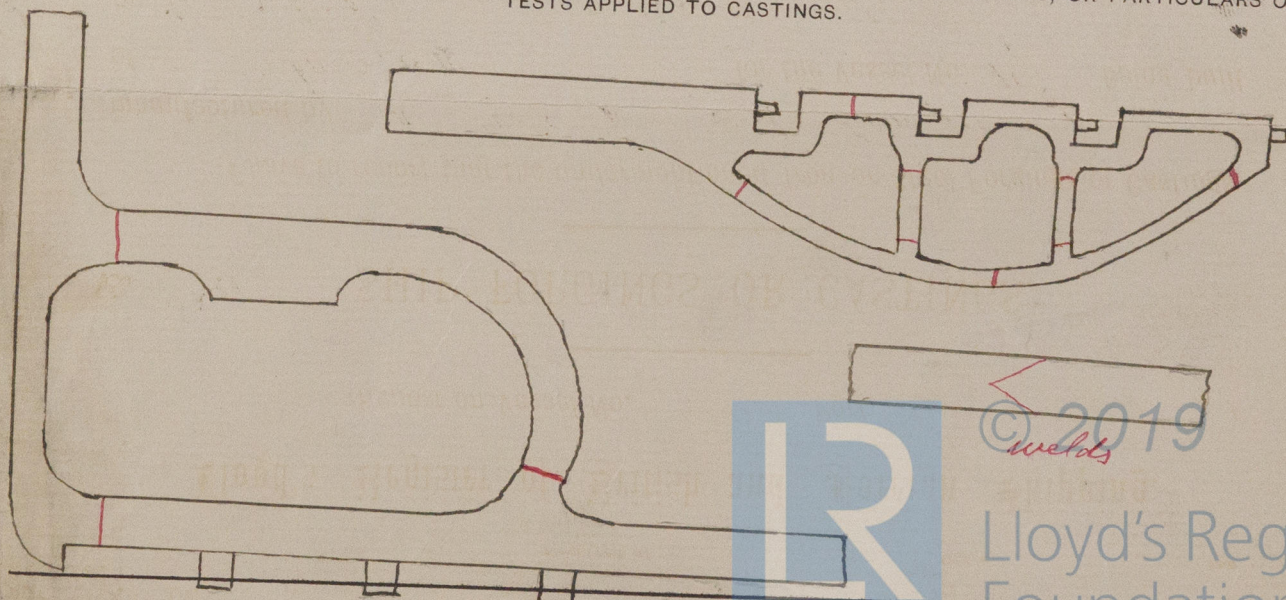





© 2019

Lloyd's Register  
Foundation