

Middle

S. J. Prudence

Received at Middlesbrough office, 24th April 1890

Lloyd's Register of British and Foreign Shipping.

(Report on Vessel No. 46 Port Inbro)

The words FORGINGS or CASTINGS, IRON or STEEL, should be struck out as may be required.

No. 209

SHIP FORGINGS OR CASTINGS.

I have to report that the undermentioned Iron ~~or Steel~~ Forgings or Castings, manufactured by The Jarrow Forge Co of Jarrow for the Vessel No. 18, being built by Messrs Craig Taylor & Co of Stockton have been inspected by me as set forth below, and found to be, so far as can be seen, sound

Mark on Forgings.

Lloyd's
No. 2513
J6



John C Craig

Newcastle

26/3/90

	STERN FRAME.	RUDDER FRAME.	STEM.
Material*	Scrap iron	Scrap iron	
How made	Forged	Forged	
Dimensions	9 - 5 1/2	7 - 3 1/2	
Progress on Inspection	Forged & Smithed	Forged & Smithed	not seen
Dates when Inspected	August 12-16-22 27	Nov 5/89 Jan 15-21-27	
	Sept 2-9-16-18/89	Feb 3-5/90	

SKETCHES OF FRAMES SHEWING POSITION AND DESCRIPTION OF WELDS OF FORGINGS, OR PARTICULARS OF TESTS APPLIED TO CASTINGS.

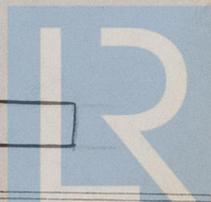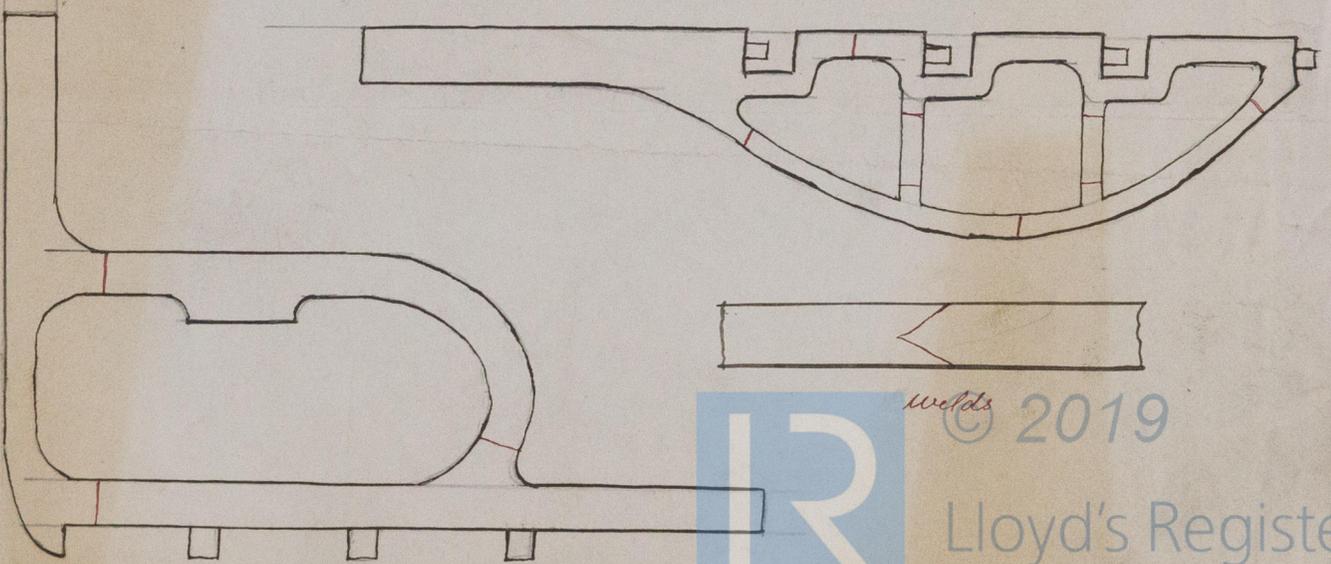





