

S. S. Prudence

Received at

West Harbourside Office. 26th July 1889

Lloyd's Register of British and Foreign Shipping.

(Report on Vessel No. 46

Port

W. Hpl

No. 1336A

SHIP FORGINGS OR CASTINGS.

The words FORGINGS or CASTINGS, IRON or STEEL, should be struck out as may be required.

I have to report that the undermentioned Iron or Steel Forgings or Castings, manufactured by

The Stratton Forge Co.

of Stratton

for the Vessel No. 18, being built by Messrs Craig Taylor & Co.

of Stratton

have been inspected by me as set forth below, and found to be, so far as can be seen, sound.

Mark on Forgings.

Lloyd's

No. 1336A

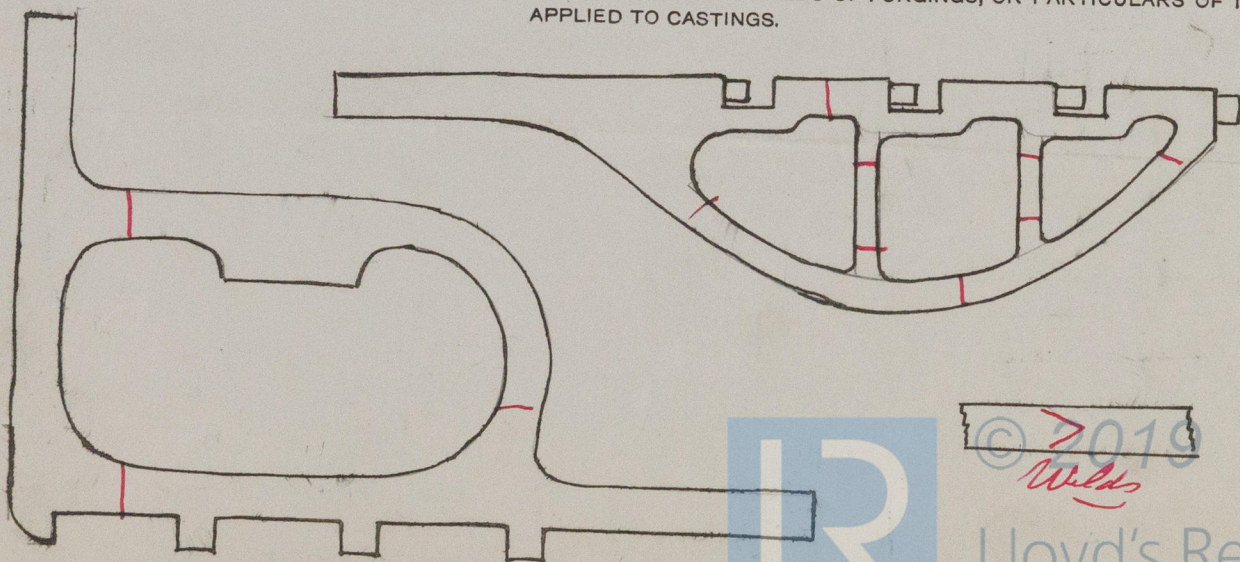
H.C.

Hugh Cameron

Sunderland 25/7/89

	STERN FRAME.	RUDDER FRAME.	STEM.
Material* - - - -	Scrap iron	Scrap iron	
How made - - - -	Forged	Forged	
Dimensions - - - -	9' x 5 1/2'	7' 3 1/2"	
Progress on Inspection -	Forged & Smithed	Forged & Smithed	not seen
Dates when Inspected	March 22-28 April 29/89 May 24-31 June 5. 14. 21 26 July 9/89		

SKETCHES OF FRAMES SHEWING POSITION AND DESCRIPTION OF WELDS OF FORGINGS, OR PARTICULARS OF TESTS APPLIED TO CASTINGS.

© 2019
WellsLloyd's Register
Foundation





© 2019

Lloyd's Register
Foundation