

S. P. Girdleness

Received at W. H. Pool Office, 15th Feb 1890

Lloyd's Register of British and Foreign Shipping.

(Report on Vessel No. 63 Port Middlebro Warburton)

W. H. Pool

No. 1497.9.

SHIP FORGINGS OR CASTINGS.

I have to report that the undermentioned Iron or Steel Forgings or Castings, manufactured by the Stockton Forge Co of Stockton for the Vessel No. 372, being built by Messrs Richardson Duck & Co of Stockton have been inspected by me as set forth below, and found to be, so far as can be seen, sound.

The words FORGINGS or CASTINGS, IRON or STEEL, should be struck out as may be required.


Mark on Forgings.

Lloyd's
No. 1497.9
80.6

August Cameron
London

	STERN FRAME.	RUDDER FRAME.	STEM.
Material* - - - -	<u>Scrap iron</u>	<u>Scrap iron</u>	<u>Scrap iron</u>
How made - - - -	<u>Fused</u>	<u>Fused</u>	<u>Fused</u>
Dimensions - - - -	<u>9' x 5'</u>	<u>7 1/2' - 3 1/2'</u>	<u>9' x 2 1/2'</u>
Progress on Inspection -	<u>Fused & Smithed</u>	<u>Fused & Smithed</u>	<u>Fused</u>
Dates when Inspected	<u>Sept 20-23-25 Oct 3-4, 12</u> <u>18/89</u>	<u>Dec 2-9-16-19-25-27-30/89</u> <u>Jan 15-17-28-30/90</u>	<u>Oct 23/89</u>

SKETCHES OF FRAMES SHOWING POSITION AND DESCRIPTION OF WELDS OF FORGINGS, OR PARTICULARS OF TESTS APPLIED TO CASTINGS.

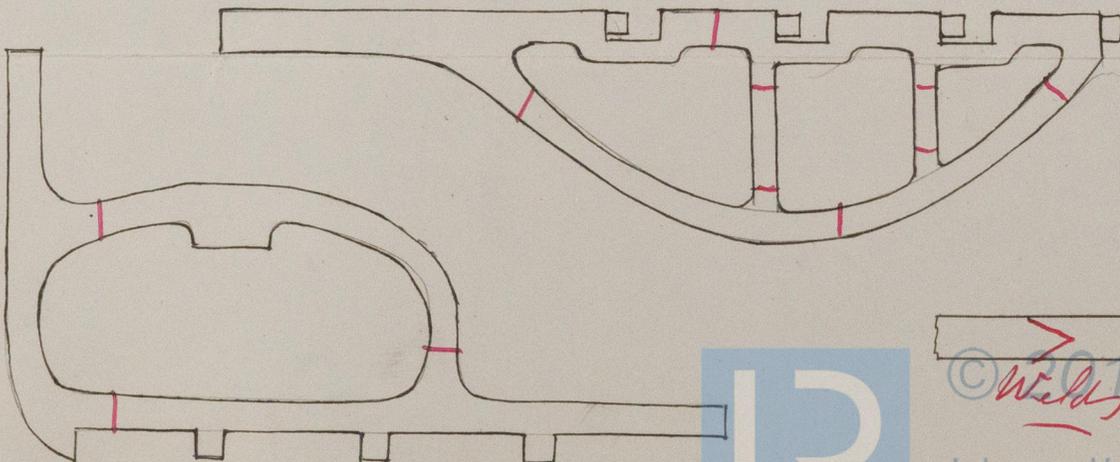

© 2019
Welds



Lloyd's Register
Foundation

* If of Iron, state whether scrap or puddled Iron.

1497











© 2019

Lloyd's Register
Foundation