

J. S. Therese Heymann

Received at Middlebro Office, 9th May 1890

Lloyd's Register of British and Foreign Shipping.

Middlebro (Report on Vessel No. 68 Port Inbro)

No. 1509. a. SHIP FORGINGS OR CASTINGS.

The words FORGINGS or CASTINGS, IRON or STEEL, should be struck out as may be required.

I have to report that the undermentioned Iron or Steel Forgings or Castings, manufactured by The Stockton Forge Co. of Stockton for the Vessel No. 246, being built by Messrs Roper & Son of Stockton have been inspected by me as set forth below, and found to be, so far as can be seen, sound

Mark on Forgings.

Lloyd's


No. 1509. a.

68. B.

W. H. Cammell
London

| | STERN FRAME. | RUDDER FRAME. | STEM. |
|--------------------------|---------------------------|--|----------------------|
| Material* - - - | <u>Scrap iron</u> | <u>Scrap iron</u> | <u>Scrap iron</u> |
| How made - - - | <u>Forged</u> | <u>Forged</u> | <u>Forged</u> |
| Dimensions - - - | <u>10' x 6"</u> | <u>7 3/4' x 3 3/4"</u> | <u>10' x 25 1/2"</u> |
| Progress on Inspection - | <u>Limited</u> | <u>Forged & Limited</u> | <u>Forged</u> |
| Dates when Inspected | <u>Dec 16-19-23-24/89</u> | <u>Feb 26 March 12-18 April 9</u> <u>14-16/90</u> | <u>Dec 16/89</u> |

SKETCHES OF FRAMES SHEWING POSITION AND DESCRIPTION OF WELDS OF FORGINGS, OR PARTICULARS OF TESTS APPLIED TO CASTINGS.

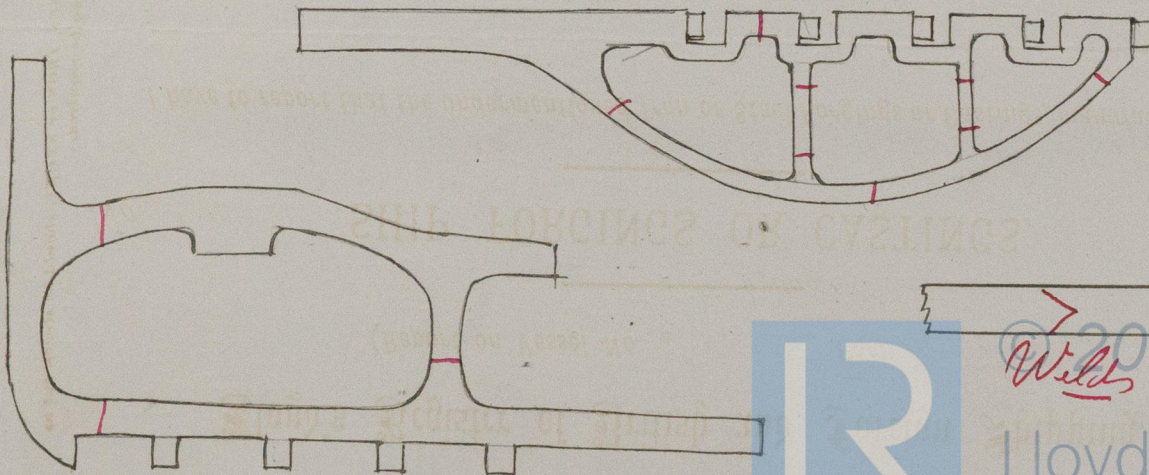

05-07-20

10

19

s Rec

(Faint handwritten notes at the bottom of the page)

ratio

© 2019

Lloyd's Register
Foundation