

S. S. Storm King

Received at

Office,

18

Lloyd's Register of British and Foreign Shipping.

Wool

(Report on Vessel No. 09 Port Middlebro')

No. 1241A.

SHIP FORGINGS OR CASTINGS.

I have to report that the undermentioned Iron or Steel Forgings or Castings, manufactured by The Darlington Lye Co. of Darlington for the Vessel No. 304, being built by Messrs R Dixon & Co. of Middlebro' have been inspected by me as set forth below, and found to be, so far as can be seen, sound.

The words FORGINGS or CASTINGS, IRON or STEEL, should be struck out as may be required.

Mark on Forgings.



Lloyd's No. 1241A O.C.

Wm Cameron

Sunderland

Table with 4 columns: Material, How made, Dimensions, Progress on Inspection, Dates when Inspected. Rows include Stern Frame, Rudder Frame, and Stem.

SKETCHES OF FRAMES SHEWING POSITION AND DESCRIPTION OF WELDS OF FORGINGS, OR PARTICULARS OF TESTS APPLIED TO CASTINGS.

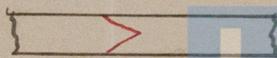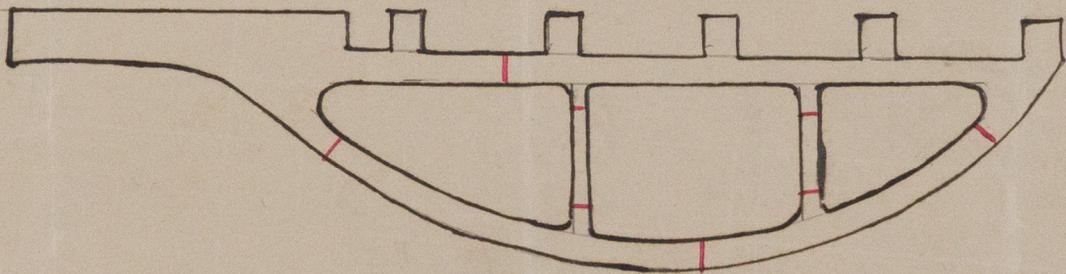

Welds

© 2019

Lloyd's Register Foundation

\* If of Iron, state whether scrap or puddled Iron.




© 2019

Lloyd's Register  
Foundation

M08739/166