

S.S. Monrovia

Received at W Hartlepool Office, 26th February 1890

Lloyd's Register of British and Foreign Shipping.

(Report on Vessel No. 40 Port W Hartlepool)

W Pool

No. 14629.

SHIP FORGINGS OR CASTINGS.

I have to report that the undermentioned Iron or Steel Forgings or Castings, manufactured by

The Darlington Forge Co. of Darlington

for the Vessel No. 313, being built by Messrs R Dixon Co.

of Middlesbrough have been inspected by me as set forth below, and found to be, so far as can be seen, sound

Mark on Forgings.

Lloyd's


No. 14629

No. 6

Hugh Cameron
Sunderland

	STERN FRAME.	RUDDER FRAME.	STEM.
Material* - - - -	Scrap iron	Scrap iron	Scrap iron
How made - - - -	Forged	Forged	Forged
Dimensions - - - -	10' x 6"	4 3/4" - 3 3/4"	10' x 23 1/4"
Progress on Inspection -	Forged & Smithed	Forged & Smithed	Forged
Dates when Inspected	Oct 1-4-7-11-17-21-29-31 Nov 6-8-11-16/89	Jan 8-14-18-28 Feb 1-6 12-17/90	Oct 11/89

SKETCHES OF FRAMES SHEWING POSITION AND DESCRIPTION OF WELDS OF FORGINGS, OR PARTICULARS OF TESTS APPLIED TO CASTINGS.

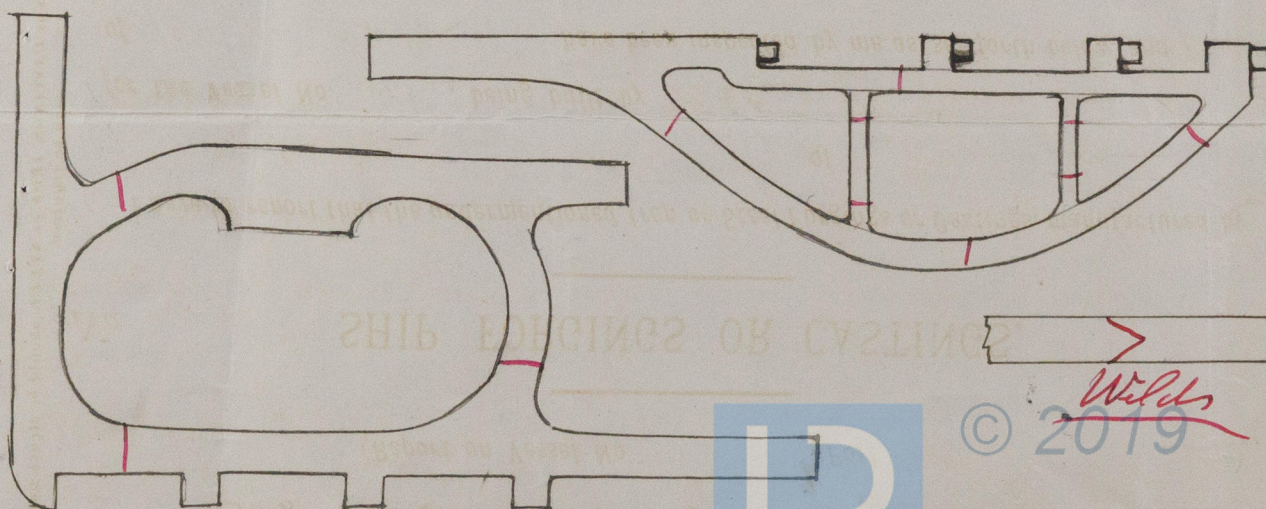

Welds

© 2019

Lloyd's Register
Foundation




© 2019

Lloyd's Register
Foundation