

S. S. Lomas

Received at Middlesbro' office, 11th March 1890

Lloyd's Register of British and Foreign Shipping.

Middlesbro (Report on Vessel No. 71 Port Inbro)

No. 1524.9 SHIP FORGINGS OR CASTINGS.

The words FORGINGS or CASTINGS, IRON or STEEL, should be struck out as may be required.

I have to report that the undermentioned Iron or Steel Forgings or Castings, manufactured by Messrs J Richardson Lons of Northford for the Vessel No. 318, being built by Messrs La Rayton Dixon & Co. of Middlesbro have been inspected by me as set forth below, and found to be, so far as can be seen, sound


Mark on Forgings.

Lloyd's No. 1524.9 10.6


W. S. Cameron Dundee 10. 3. 90

Table with 4 columns: STERN FRAME, RUDDER FRAME, STEM, and rows for Material, How made, Dimensions, Progress on Inspection, and Dates when Inspected.

SKETCHES OF FRAMES SHEWING POSITION AND DESCRIPTION OF WELDS OF FORGINGS, OR PARTICULARS OF TESTS APPLIED TO CASTINGS.

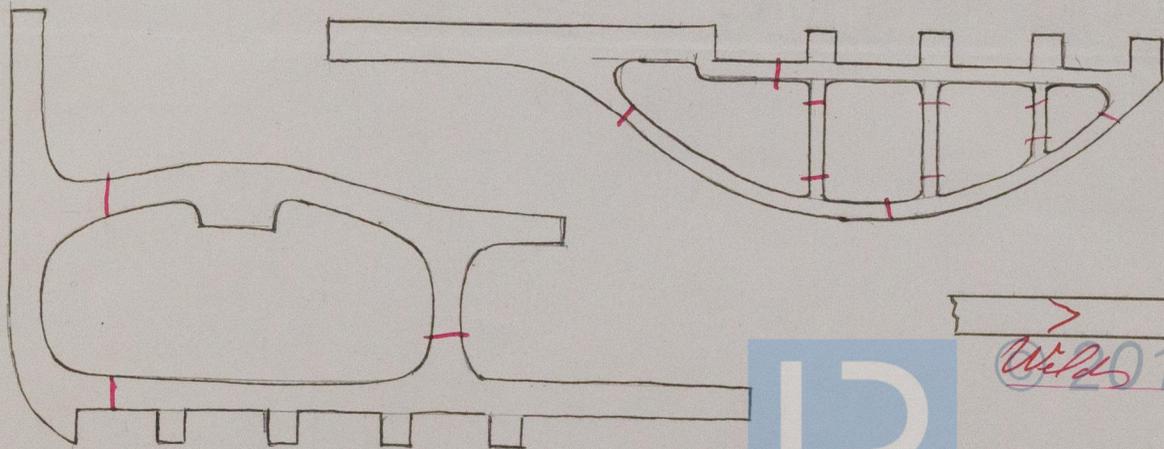

Welds 2019

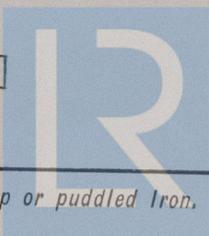

Lloyd's Register Foundation

* If of Iron, state whether scrap or puddled Iron.

1524

SHIP FORGINGS OR CASTINGS



Lloyd's

© 2019



Lloyd's Register
Foundation