


# SKETCH SHEWING WEB FRAMES IN LIEU OF HOLD BEAMS

N<sup>o</sup> 315

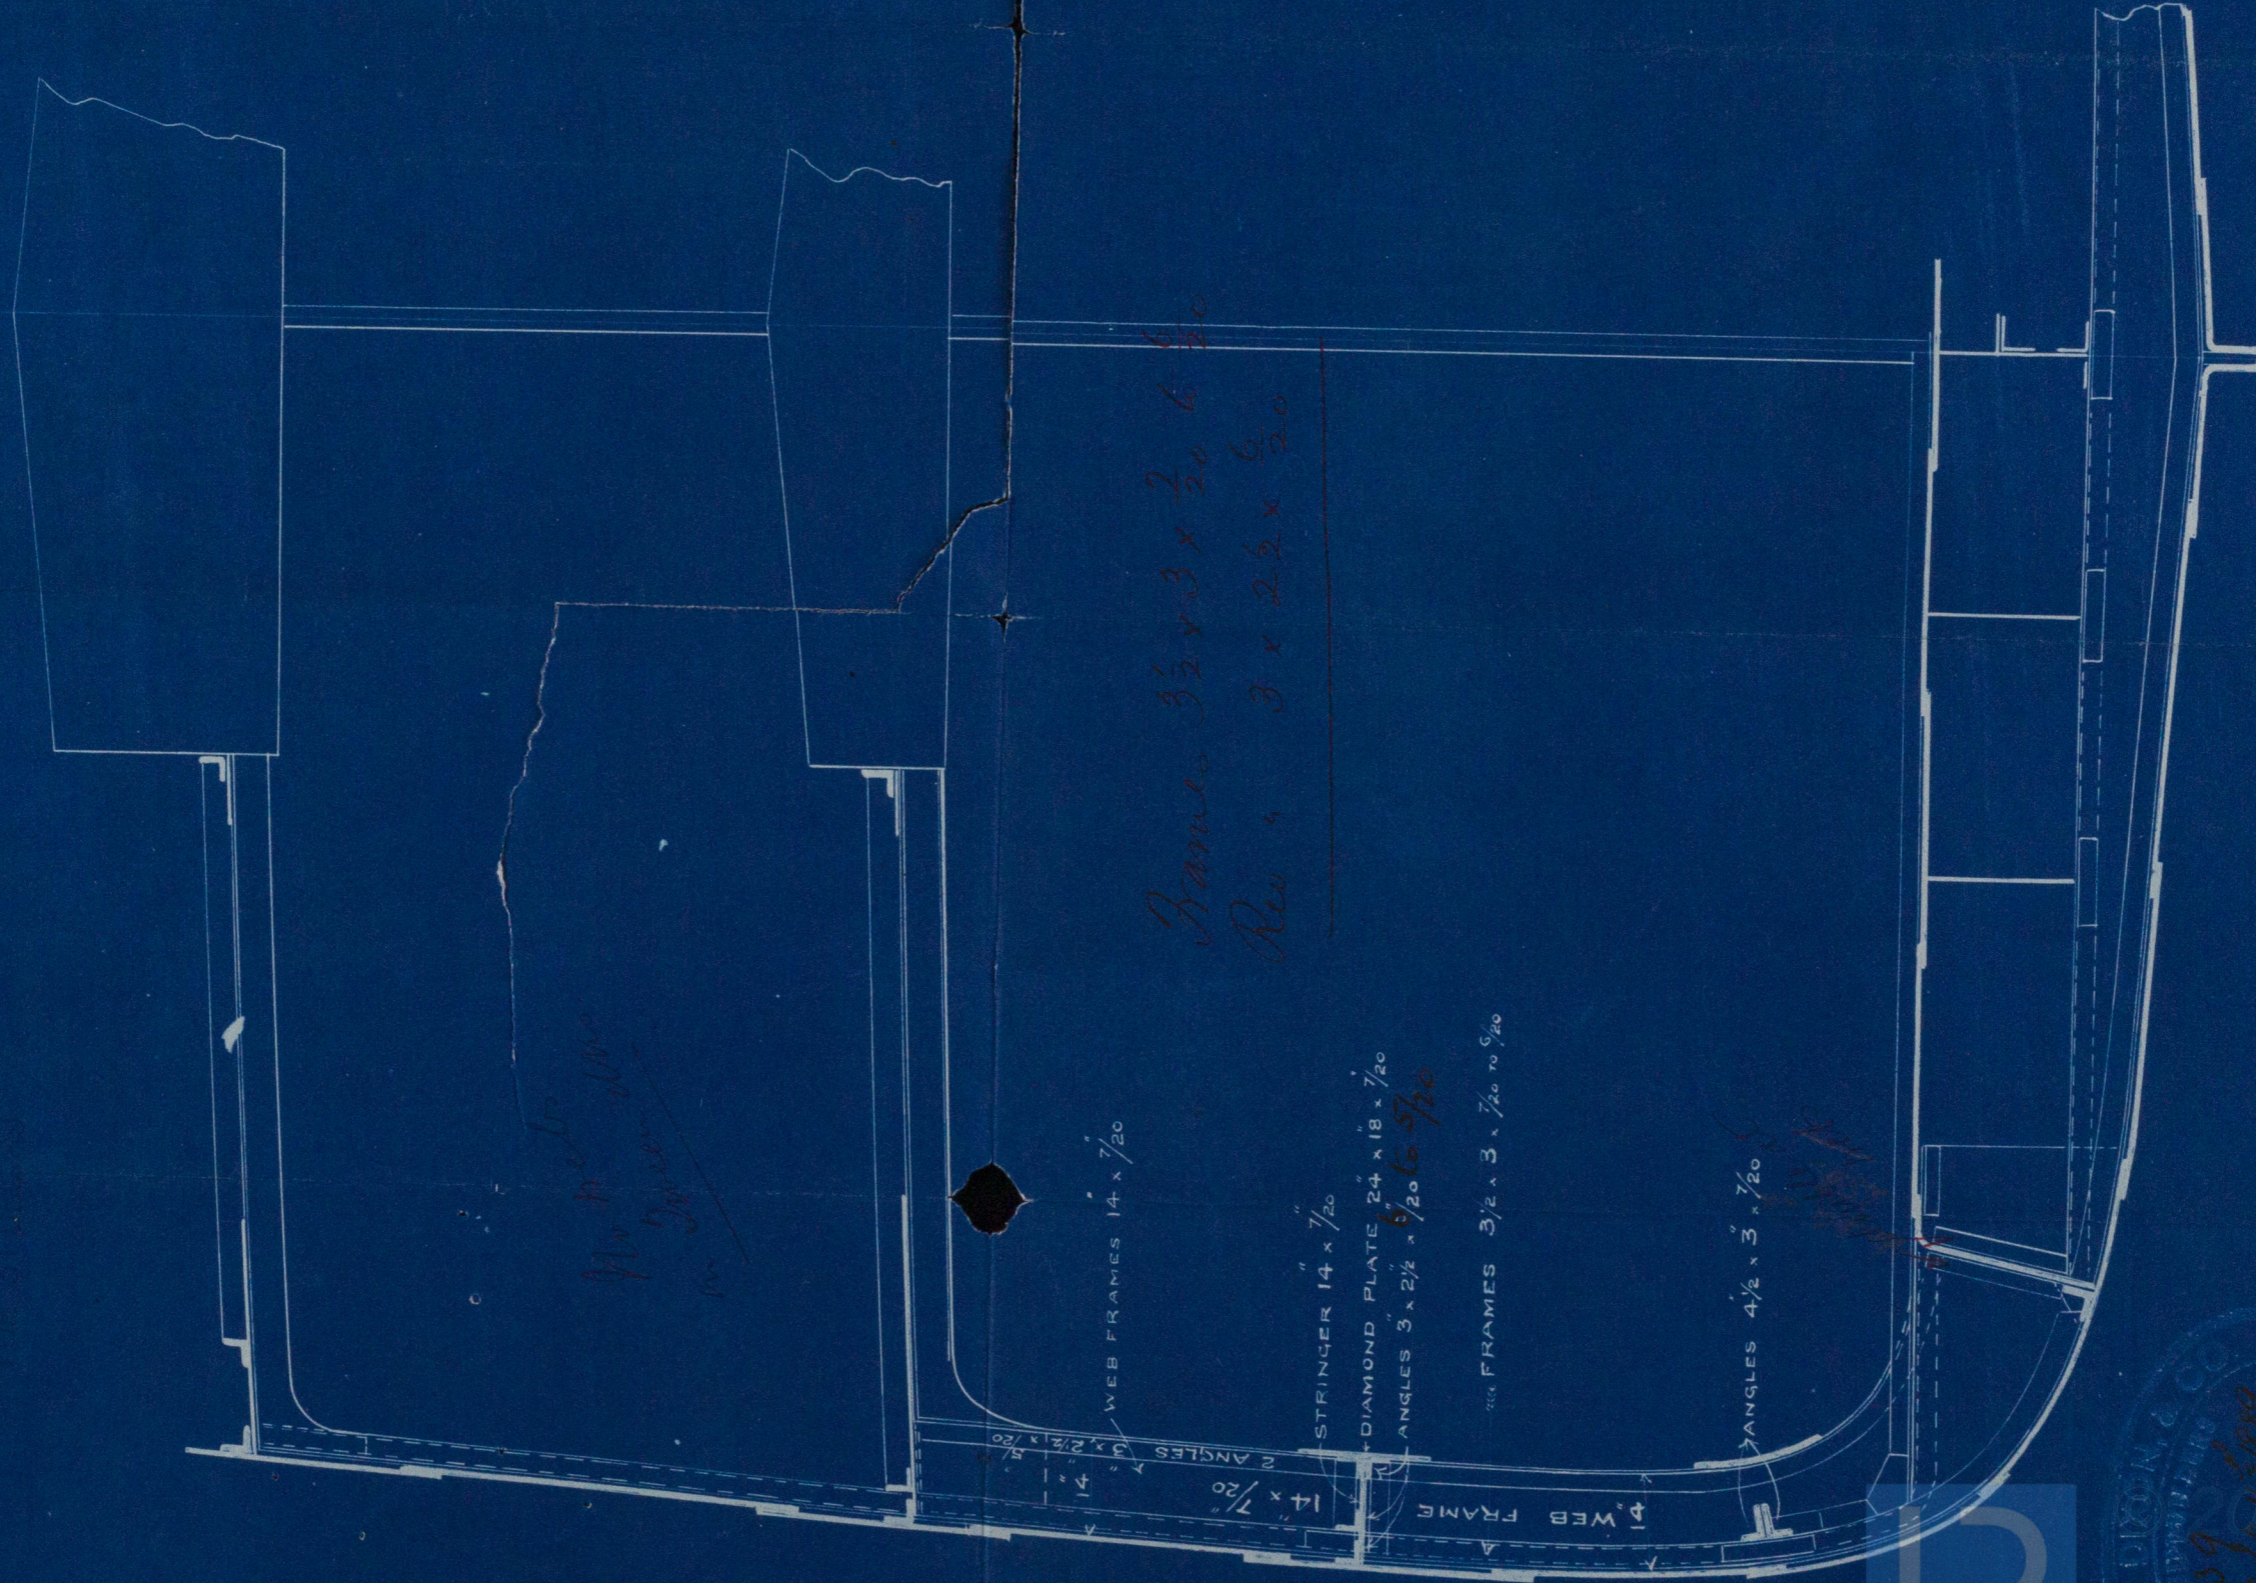


SCALE  $\frac{1}{2}$  INCH = ONE FOOT

N<sup>o</sup> 315

MOSES 739/206





P. Dicm. &  
Mln

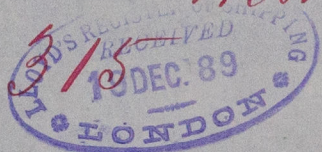


Elle

Midship Section  
showing web frames.

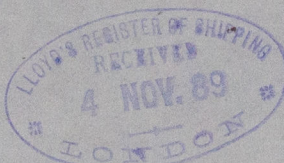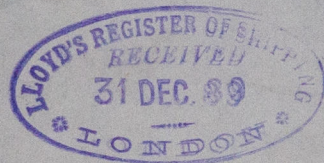

Yumuri  
Middleborough  
Nov 73

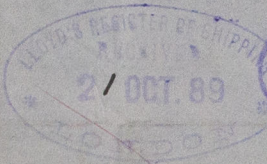

2/34



© 2019

Lloyd's Register  
Foundation