

S. S. Yumuri

Received at Middlesbro office, 11th March 1890

Lloyd's Register of British and Foreign Shipping.

Middlesbro (Report on Vessel No. 43 Port Mbro.)

No. 1537.9 SHIP FORGINGS OR CASTINGS.

I have to report that the undermentioned Iron or Steel Forgings or Castings, manufactured by
The Darlington Forge Co. of Darlington
for the Vessel No. 315, being built by Sir Raylton Dixon & Co.
of Middlesbro have been inspected by me as set forth below, and found
to be, so far as can be seen, sound.

Mark on Forgings.

Lloyd's

No. 1537.9



10. 3.

Wm. Cameron

10. 3. 90

	STERN FRAME.	RUDDER FRAME.	STEM.
Material*	Scrap iron	Scrap iron	Scrap iron
How made	Forged	Forged	Forged
Dimensions	7' 4 1/2"	4 3/4' - 3"	6 3/4' x 2 1/8'
Progress on Inspection	Forged Smiths	Forged Smiths	Forged
Dates when Inspected	Nov 6-8-16-21/89	Jan 8-14-18-27-29/90 12-21/90	Nov 21/89

SKETCHES OF FRAMES SHEWING POSITION AND DESCRIPTION OF WELDS OF FORGINGS, OR PARTICULARS OF TESTS APPLIED TO CASTINGS.

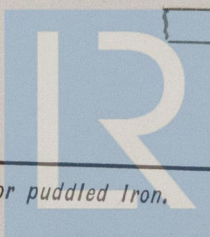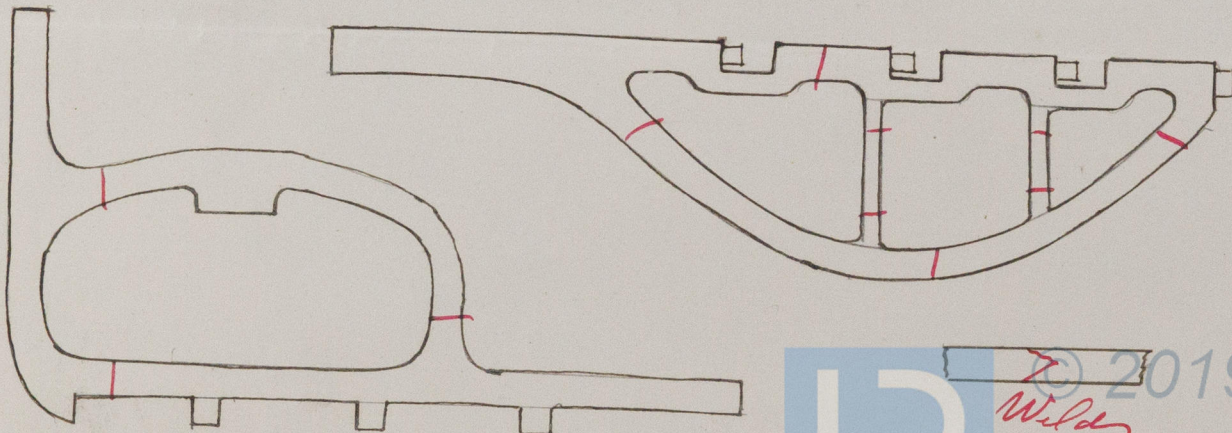

© 2019
Wilde

Lloyd's Register
Foundation
















© 2019

Lloyd's Register
Foundation