



R Dixon & Co
Mbro

Nos ~~313~~ 314

Midship Section

314 S.S. ~~MONROVIA~~
RUSKIN

Mbro Report No 49

 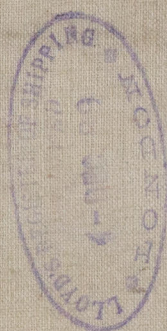

MD3739/225



© 2019

Lloyd's Register
Foundation