

S.S. Montebello

Received at Middlesbrough Office, 12th March 1890

Lloyd's Register of British and Foreign Shipping.

Middlesbrough

(Report on Vessel No. 88 Port Middlesbrough)

No. 1496A

SHIP FORGINGS ^{and} OR CASTINGS.

I have to report that the undermentioned Iron ^{and} or Steel Forgings ^{and} or Castings, manufactured by the Darlington Forge Co. & the Stockton Forge Co. of Darlington & Stockton for the Vessel No. 371, being built by Messrs Richardson Dunn & Co. of Stockton have been inspected by me as set forth below, and found to be, so far as can be seen, sound.

This cast steel stern frame was tested in accordance with the Rules and found satisfactory

Mark on Forgings.

Lloyd's

No. 1496A
No. 6.

Rush Cameron

Sunderland 8. 3. 90.

Darlington Forge Co.

Stockton Forge Co.

Stockton Forge Co.



STERN FRAME.

RUDDER FRAME.

STEM.

Material*	Sumner steel	Scrap iron	Scrap iron
How made	Cast	Forged	Forged
Dimensions	as per drawing attached	7'-3 1/2'	9'-2 1/2'
Progress on Inspection	Cast and finished	Forged & smithed	Forged
Dates when Inspected	Nov 8-28 Dec 3-6-11/89	Jan 17-30 Feb 5-12-17-26/90	Oct 12/89

SKETCHES OF FRAMES SHEWING POSITION AND DESCRIPTION OF WELDS OF FORGINGS, OR PARTICULARS OF TESTS APPLIED TO CASTINGS.

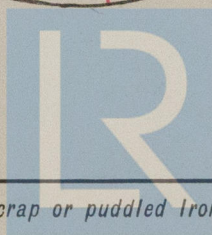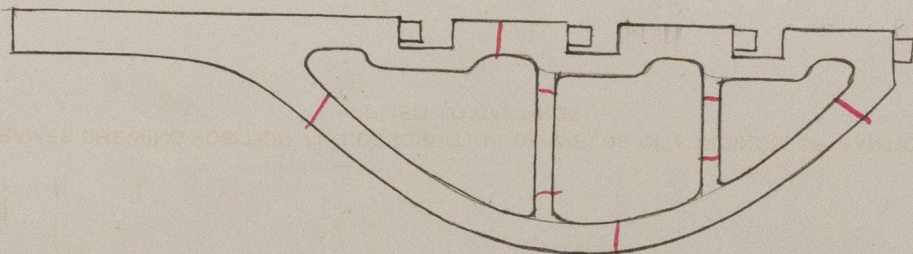

© 2019

Wildey

Lloyd's Register
Foundation




© 2019

Lloyd's Register
Foundation