



6 DEC 89

SKETCH SHEWING POSITION OF SIDELIGHTS
AND
PROPOSED COMPENSATION

S, S, N° 371


SCALE $\frac{1}{2}$ = 1 FOOT



THIS STRAKE INCREASED
FROM $\frac{8}{20}$ TO $\frac{9}{20}$ AS COMPENSATION
8' HOLES FOR SIDELIGHTS 5 & 6
SPACES APART

These lights spaced much closer than before

8' LIGHTS SPACE 5 & 6 SPACES

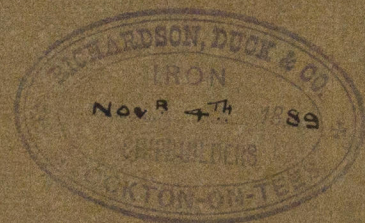

© 2019

Lloyd's Register
Foundation



MD5739/240

Richardson Duck & Co

Nº 32/1

S. S. Montebello

Intro Report Nº 88

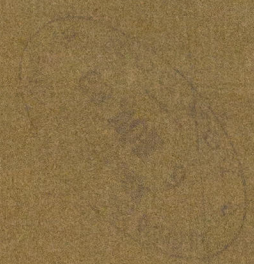 

© 2019

Lloyd's Register
Foundation

MD8739/240

