
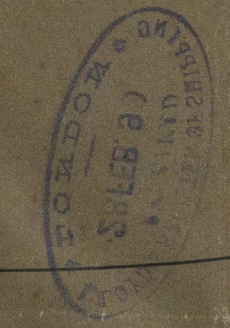


FRI 21 FEB 90  
FRI 28 FEB 90

PLAN SHEWING ALTERATIONS TO S.S. N° 122

SCALE 1/8" = ONE FOOT.

ALTERATIONS IN RED

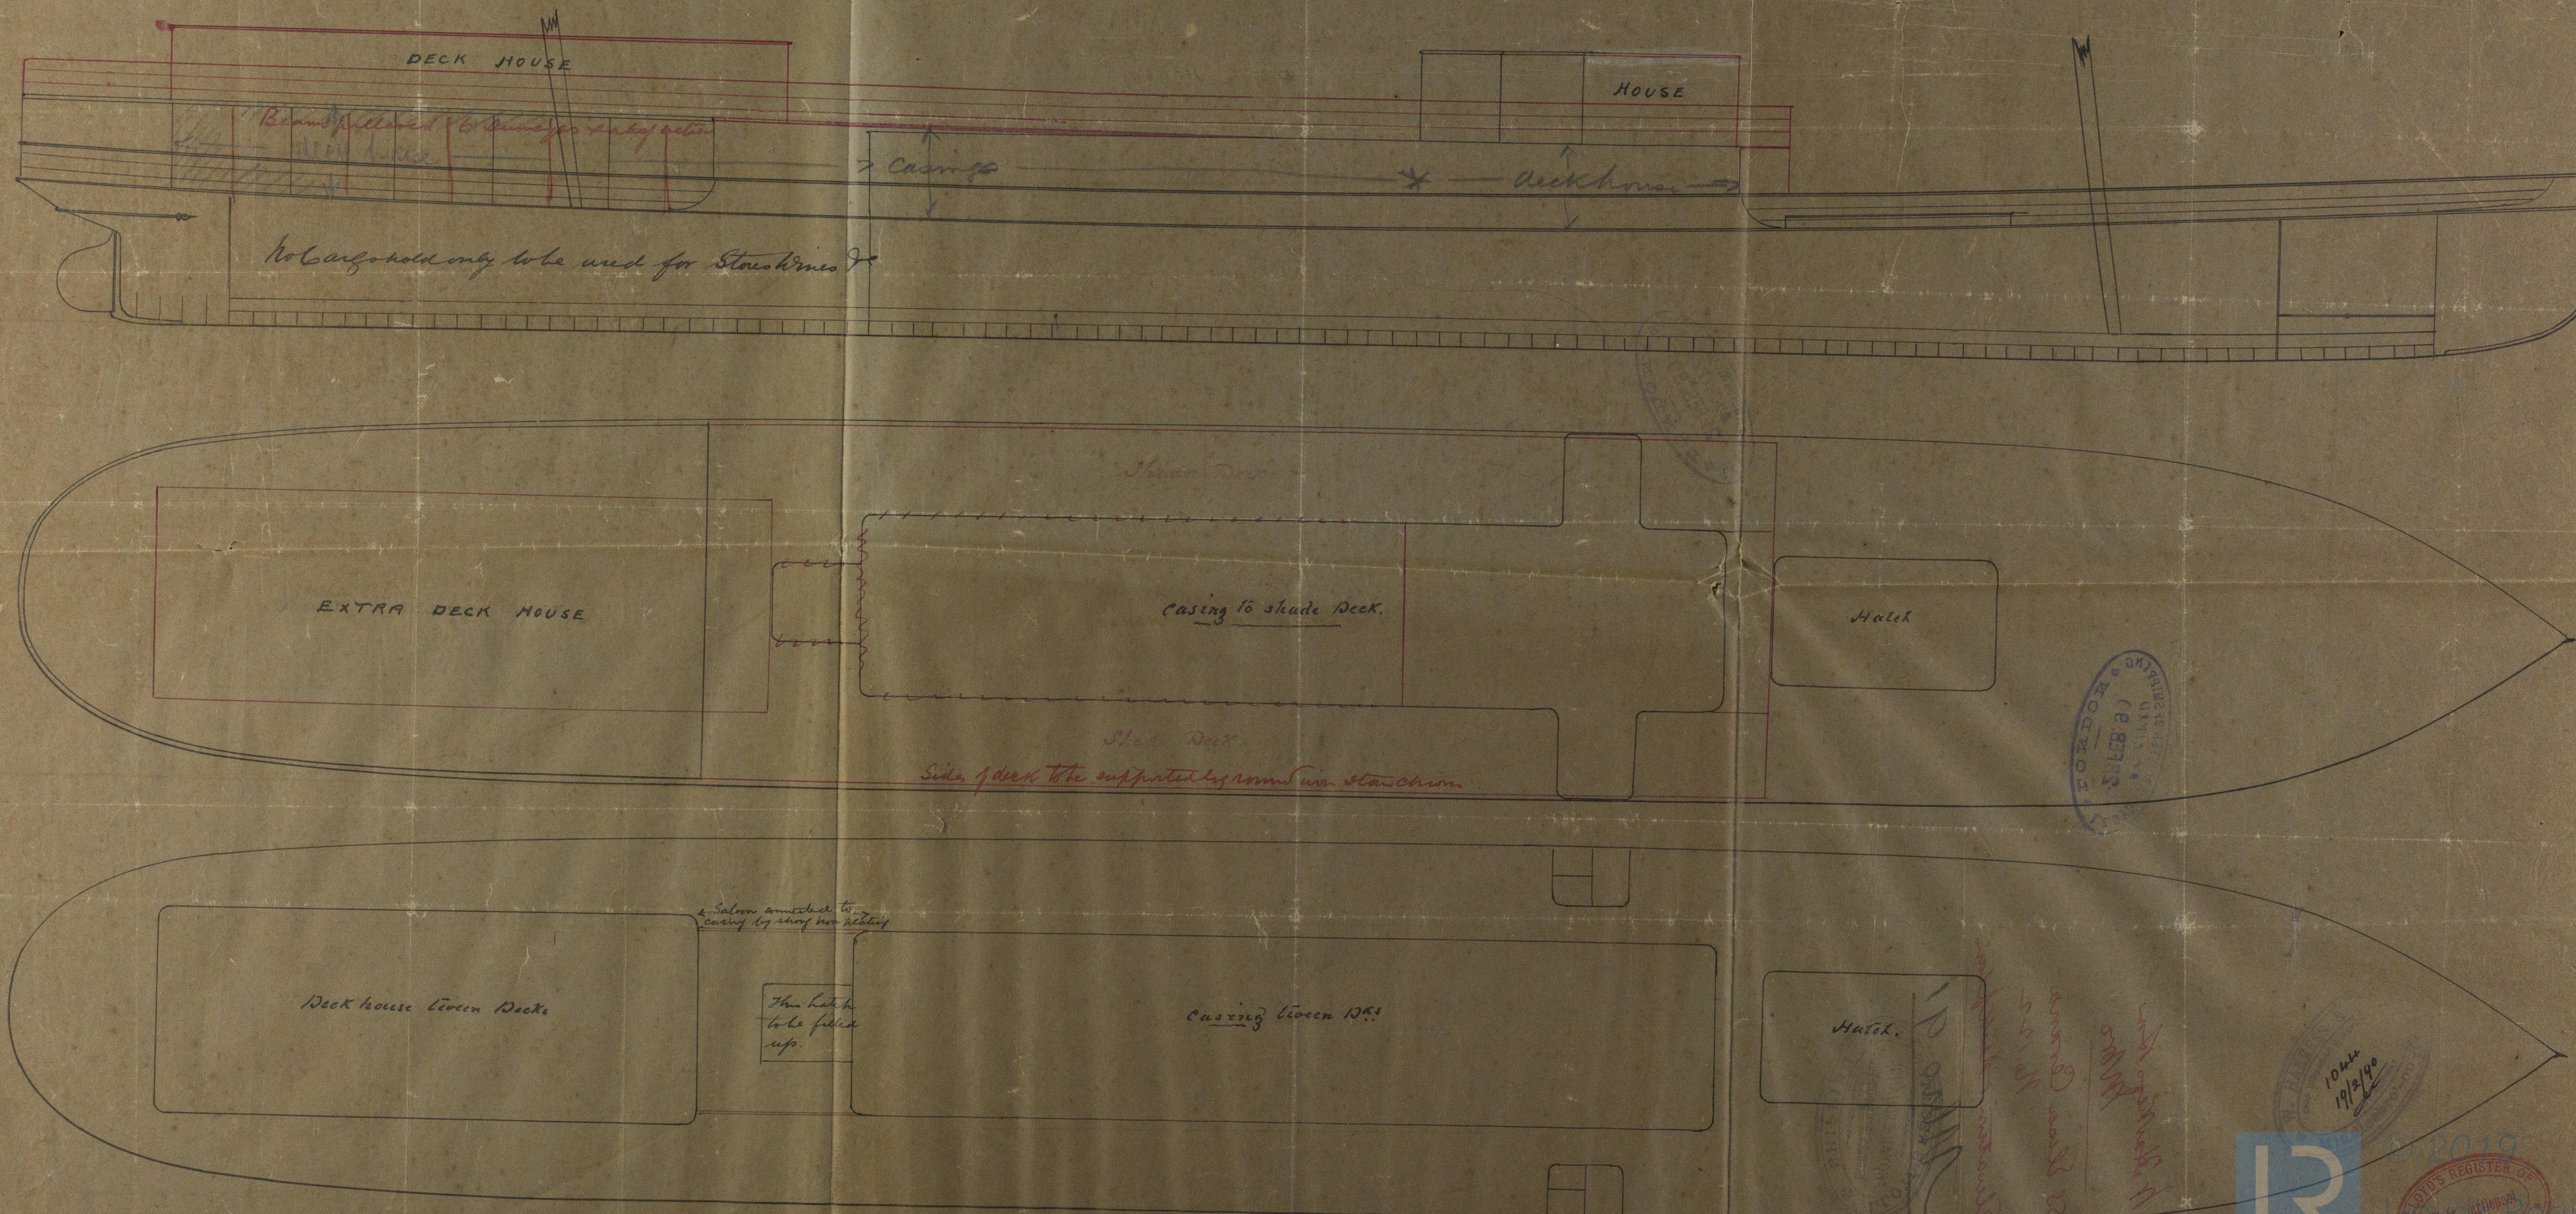


LLOYD'S REGISTER OF SHIPPING  
1044  
19/2/90


M637391278



MSA 91/278

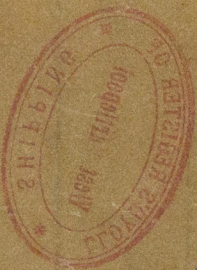

1891




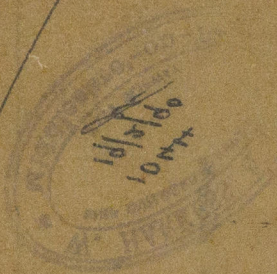


*H. Harkness Am  
Mbro*

*SS Elisa Cerana  
No 122*

*Elevation & Deck plan*

*Mbro 91*

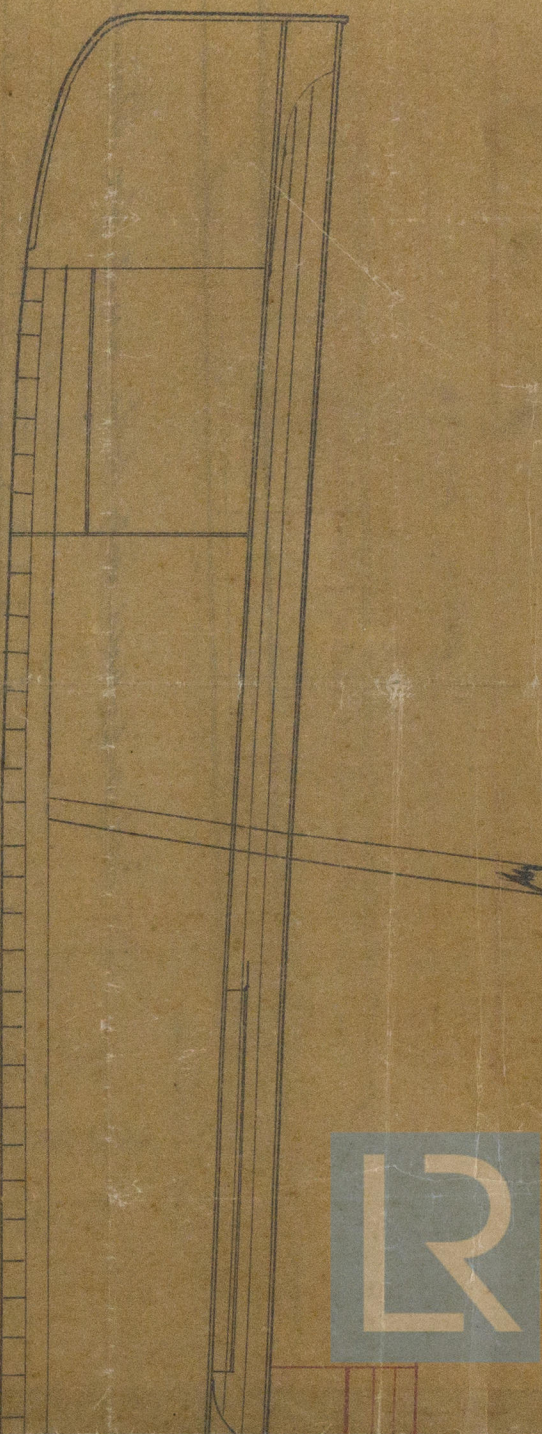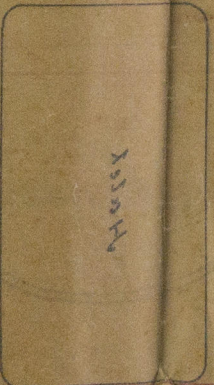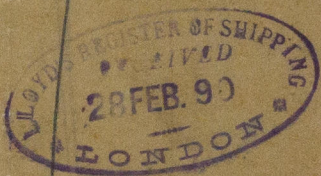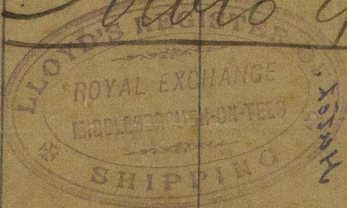

© 2019

Lloyd's Register  
Foundation