



Ltr. 31. 3. 90.

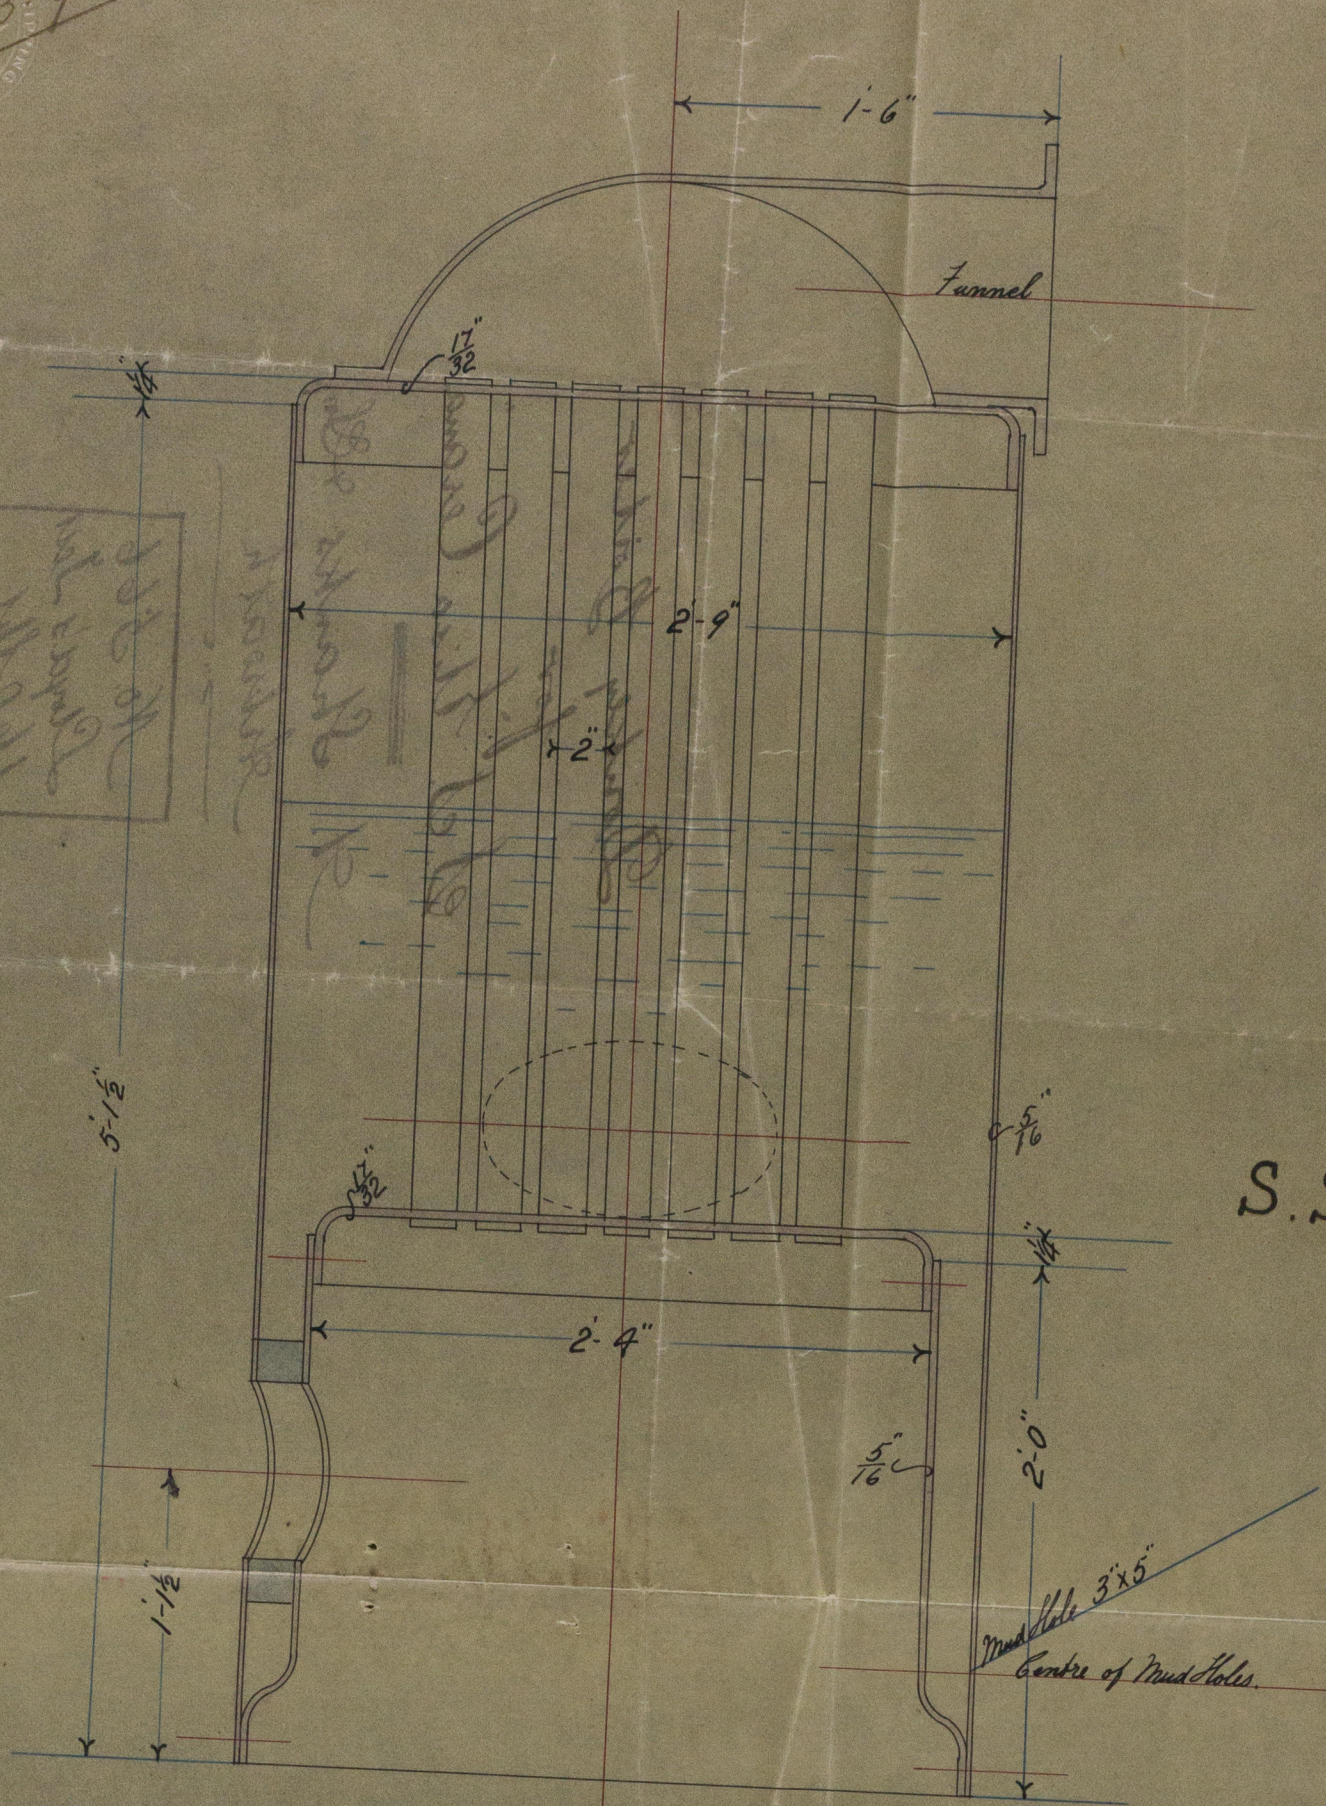

S.S. "Elisa Cerana"
Report No.



26/3/90.

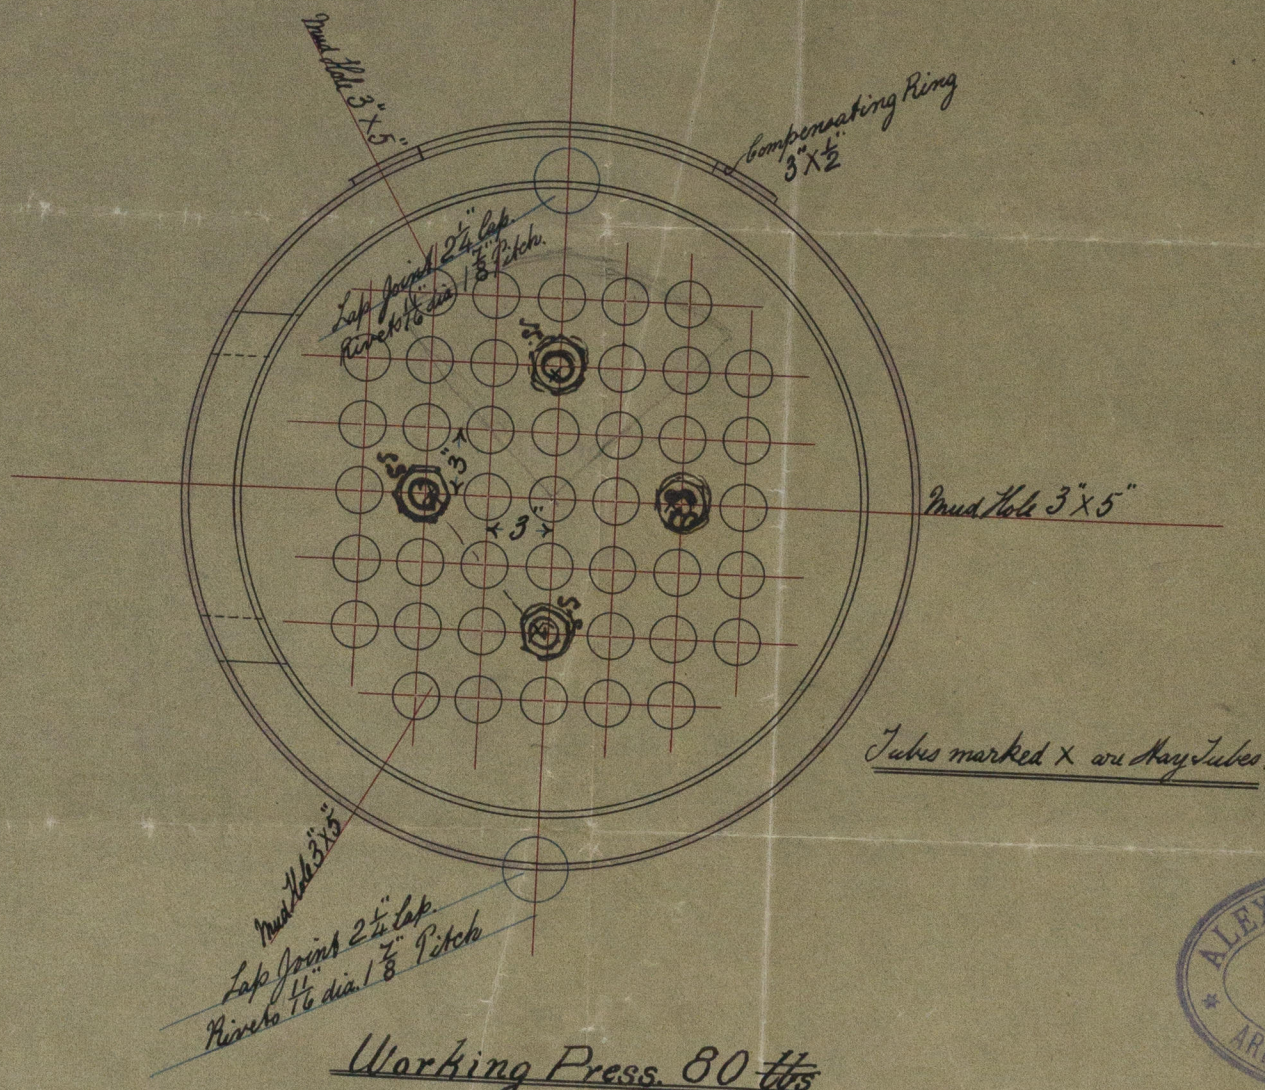

The last appears to be 1 1/2" = 1/2" pitch

N.A.
28.3.90

Working Press. 80 lbs

Boiler to be made of Steel throughout except Tubes.

All holes to be drilled after plates are bent.

Tubes No 11 B.W.G. 2" dia. Stay Tubes 3/4" thick screwed through both plates.



© 2019

Lloyd's Register Foundation


Tracing No 90/90.

MBS739/281

Donkey Boiler
for
S. S. Elisa Cerana
A. Shanks & Son
Arbroath.

No. 566
Lloyd's Test
160 lbs.
A.E.K. 14/5/90

Dundee.
Report No.
Mbro. 91

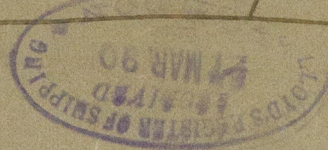

© 2019

Lloyd's Register
Foundation

MLBT39/281