



comp

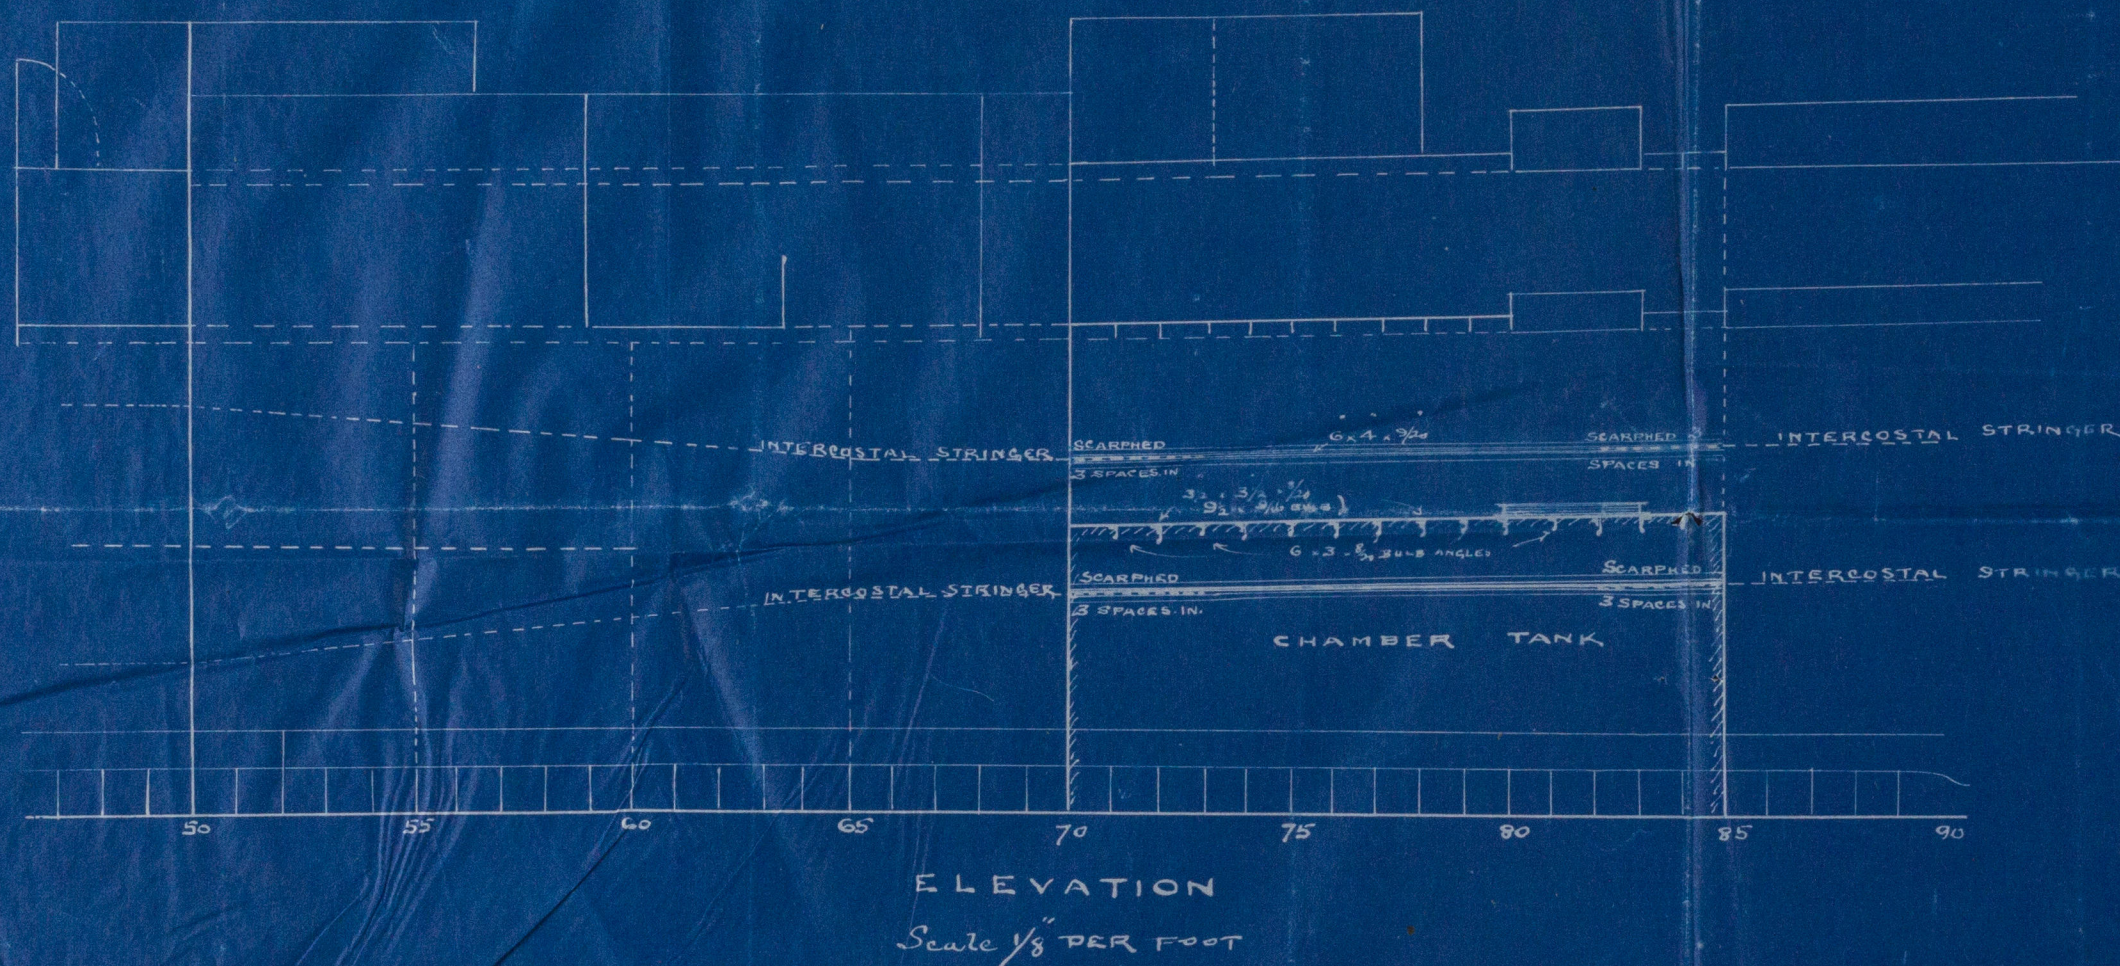

PROPOSED ARRANGEMENT OF STRINGERS IN LIEU OF WEBFRAMES
IN WAY OF
CHAMBER TANK

— N^o 317 to 322 —


24/6
21/12/89

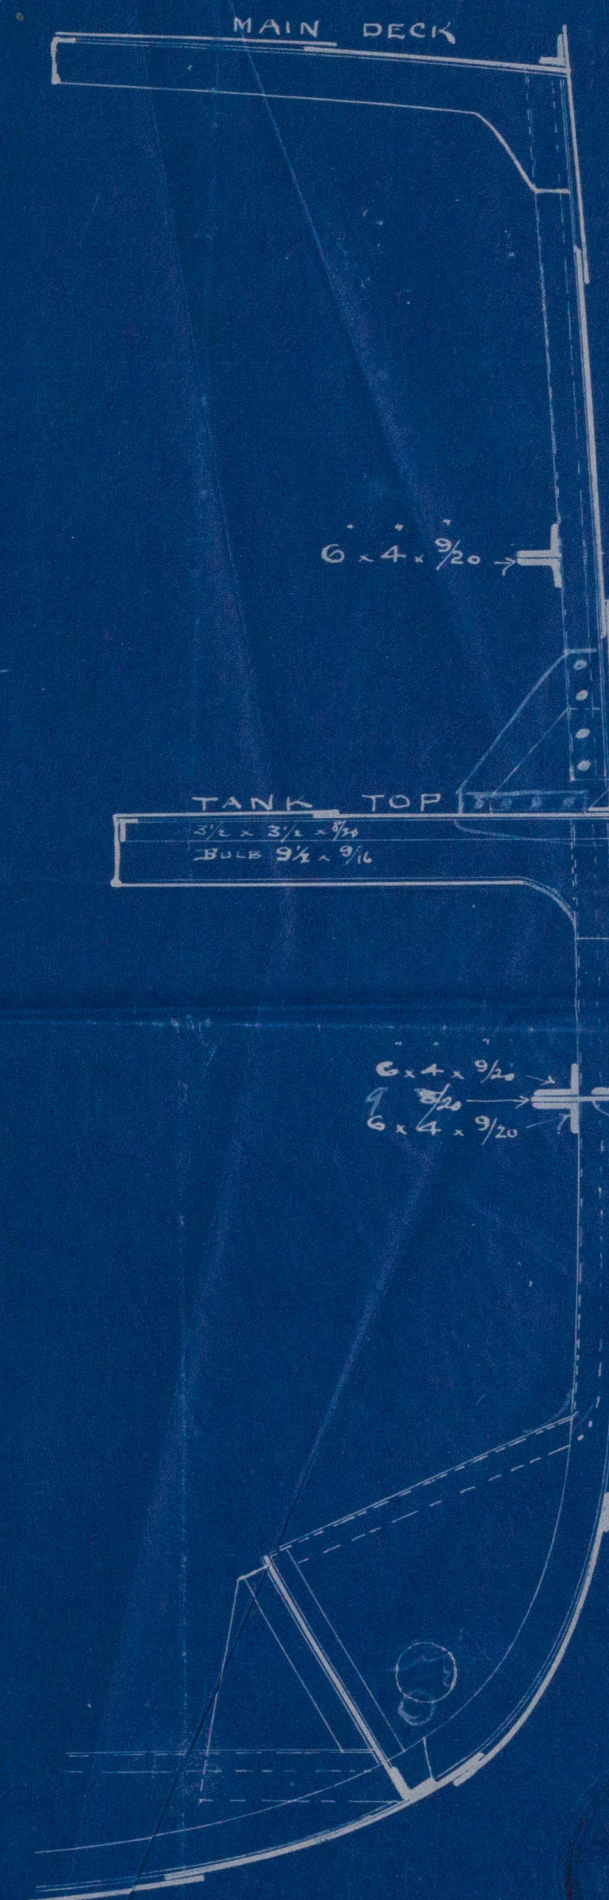

— SECTION —

— Scale 1/2 PER FOOT —

N.M.M.
19.12.89

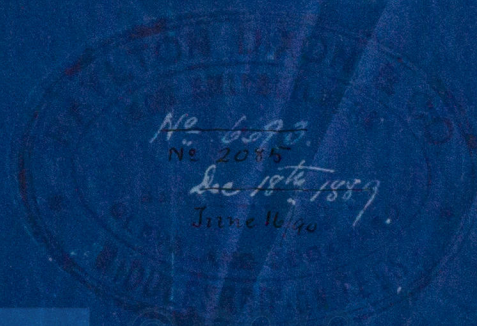

RAYLTON DIXON & CO
IRON SHIPBUILDERS
CLEVELAND DOCKYARD
MIDDLESBROUGH

11/12/12/1


SS. No 319

Plan of deep Tank

S. L. Sandil

Mrs Rept No 94

Copied
in



© 2019

Lloyd's Register
Foundation

MD739/291