

S. P. Landil

Received at Middlebro' office, 26th March 1890

Lloyd's Register of British and Foreign Shipping.

Middlebro (Report on Vessel No. 94 Port Middlebro)

No. 1539.A. SHIP FORGINGS OR CASTINGS.

I have to report that the undermentioned Iron or Steel Forgings or Castings, manufactured by The Stratton Forge Co. of Stratton for the Vessel No. 319, being built by Messrs R Dixon Co. of Middlebro have been inspected by me as set forth below, and found to be, so far as can be seen, sound.

The words FORGINGS or CASTINGS, IRON or STEEL, should be struck out as may be required.


Mark on Forgings.

Lloyd's
No. 1539A
R.D.C.

Wm Cameron
Sunduland
25. 3. 90

| | STERN FRAME. | RUDDER FRAME. | STEM. |
|------------------------|-------------------|--------------------|-------------|
| Material* | Scrap iron | Scrap iron | Scrap iron |
| How made | Forged | Forged | Forged |
| Dimensions | 10 x 6" | 4 3/4" | 10 x 2 3/4" |
| Progress on Inspection | Forged & smithed | Forged & smithed | Forged |
| Dates when Inspected | Nov 7-11-14-22-29 | Jan 27-30 Feb 5-12 | Nov 11/89 |
| | Dec 29-16-19/89 | 17-26 March 12/90 | |

SKETCHES OF FRAMES SHEWING POSITION AND DESCRIPTION OF WELDS OF FORGINGS, OR PARTICULARS OF TESTS APPLIED TO CASTINGS.

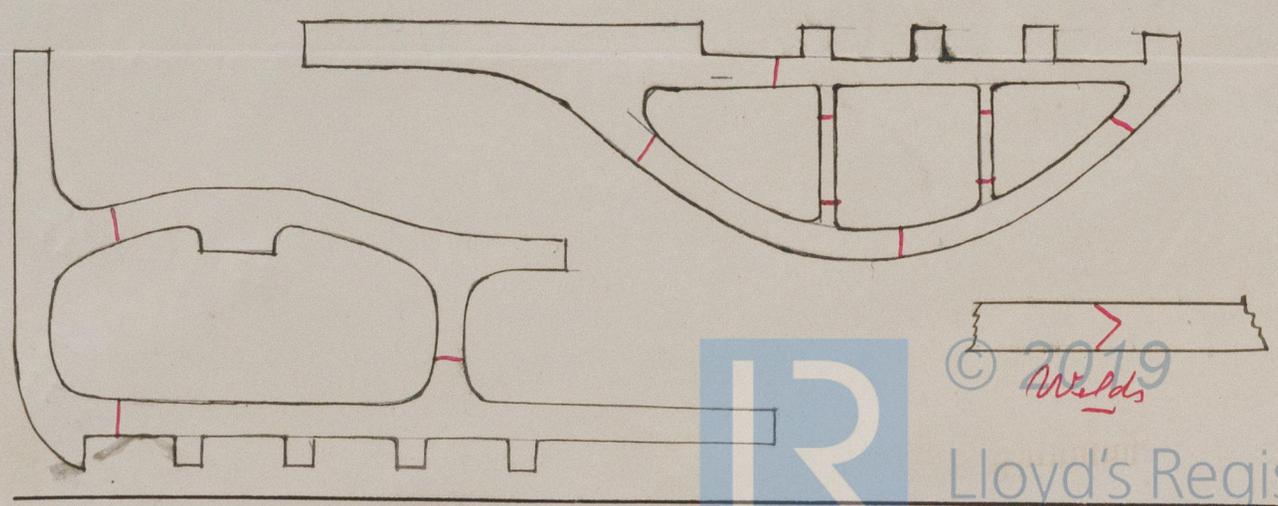

© 2019 Welds
Lloyd's Register Foundation

[T.&S. - 2000 - 27/8 89 - Trans. Ink.]

* If of Iron, state whether scrap or puddled Iron.

1539

Faint, illegible text at the top of the page, possibly a header or title.

SHIP TONNAGES OR CASTINGS






© 2019

Lloyd's Register
Foundation