

S.S. Hokkai Maru

Received at Middlesbrough office 28<sup>th</sup> May 1890

# Lloyd's Register of British and Foreign Shipping.

(Report on Vessel No. 113 Port Mbro )

No 271

## SHIP FORGINGS OR CASTINGS.

The words FORGINGS or CASTINGS, IRON or STEEL, should be struck out as may be required.

I have to report that the undermentioned Iron ~~or Steel~~ Forgings ~~or Castings~~, manufactured by

Messrs The Jarrow Forge Co of Jarrow  
for the Vessel No. 21, being built by Messrs Craig Taylor & Co  
of Stockton have been inspected by me as set forth below, and found  
to be, so far as can be seen, sound

Mark on Forgings.

Lloyd's  
No. 89 B  
86


John C Craig

Newcastle

19/5/90

	STERN FRAME.	RUDDER FRAME.	STEM.
Material* . . . .	Scrap iron	Scrap iron	
How made . . . .	Forged	Forged	
Dimensions . . . .	6 1/2 - 3 1/4	4 1/4 - 2 1/2	
Progress on Inspection .	Forged & Smithed	Forged & Smithed	not seen
Dates when Inspected	Dec 26/89 Jan 7-13-21/27	April 22-28	*
	Feb 13-21-24/90	May 12/90	

SKETCHES OF FRAMES SHEWING POSITION AND DESCRIPTION OF WELDS OF FORGINGS, OR PARTICULARS OF TESTS APPLIED TO CASTINGS.

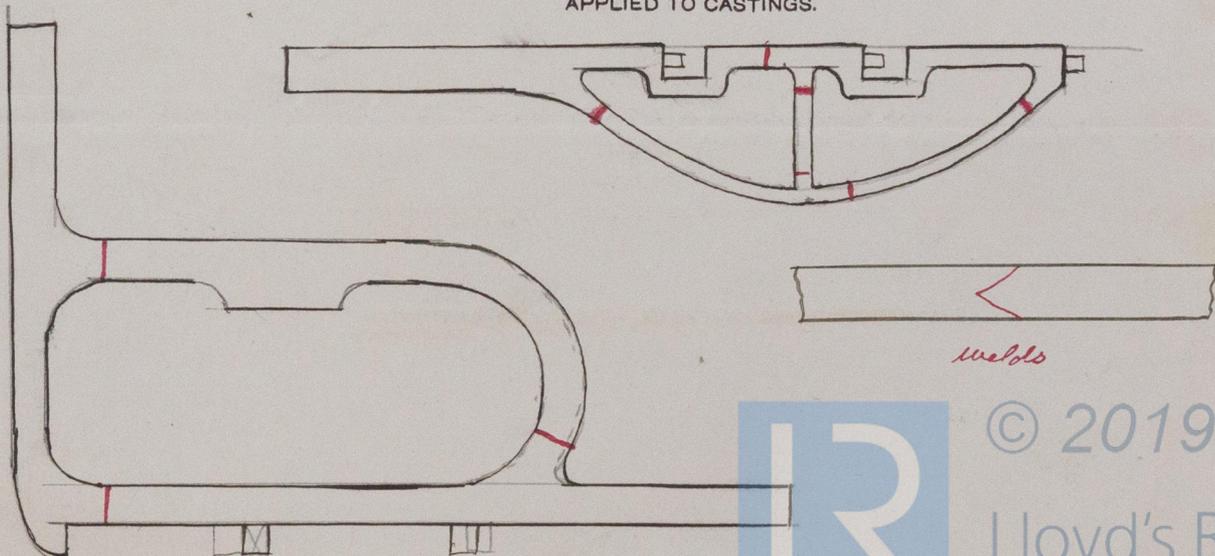

© 2019

Lloyd's Register  
Foundation

\* If of Iron, state whether scrap or puddled Iron.
















© 2019

Lloyd's Register  
Foundation