


# SKETCH OF BRIDGE SIDE PLATING

N<sup>o</sup> 248.S.S.

SHewing ALTERNATIVE ARRANGEMENT TO PROVISIONS OF SEC. 44 PAR. 9 & 10.

MON 15 JUL 89  
THU 15 SEP 89

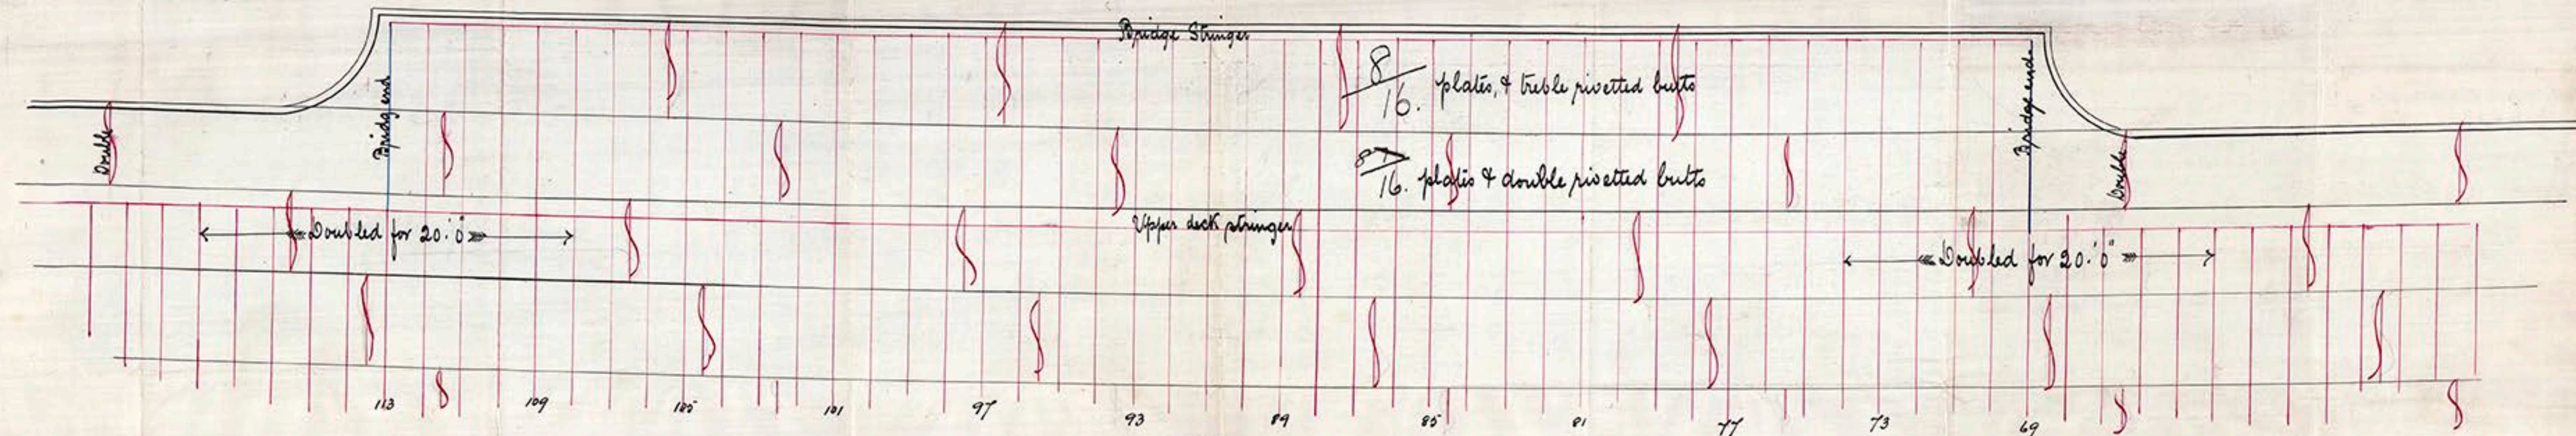



15/7/89



© 2018

Lloyd's Register  
Foundation



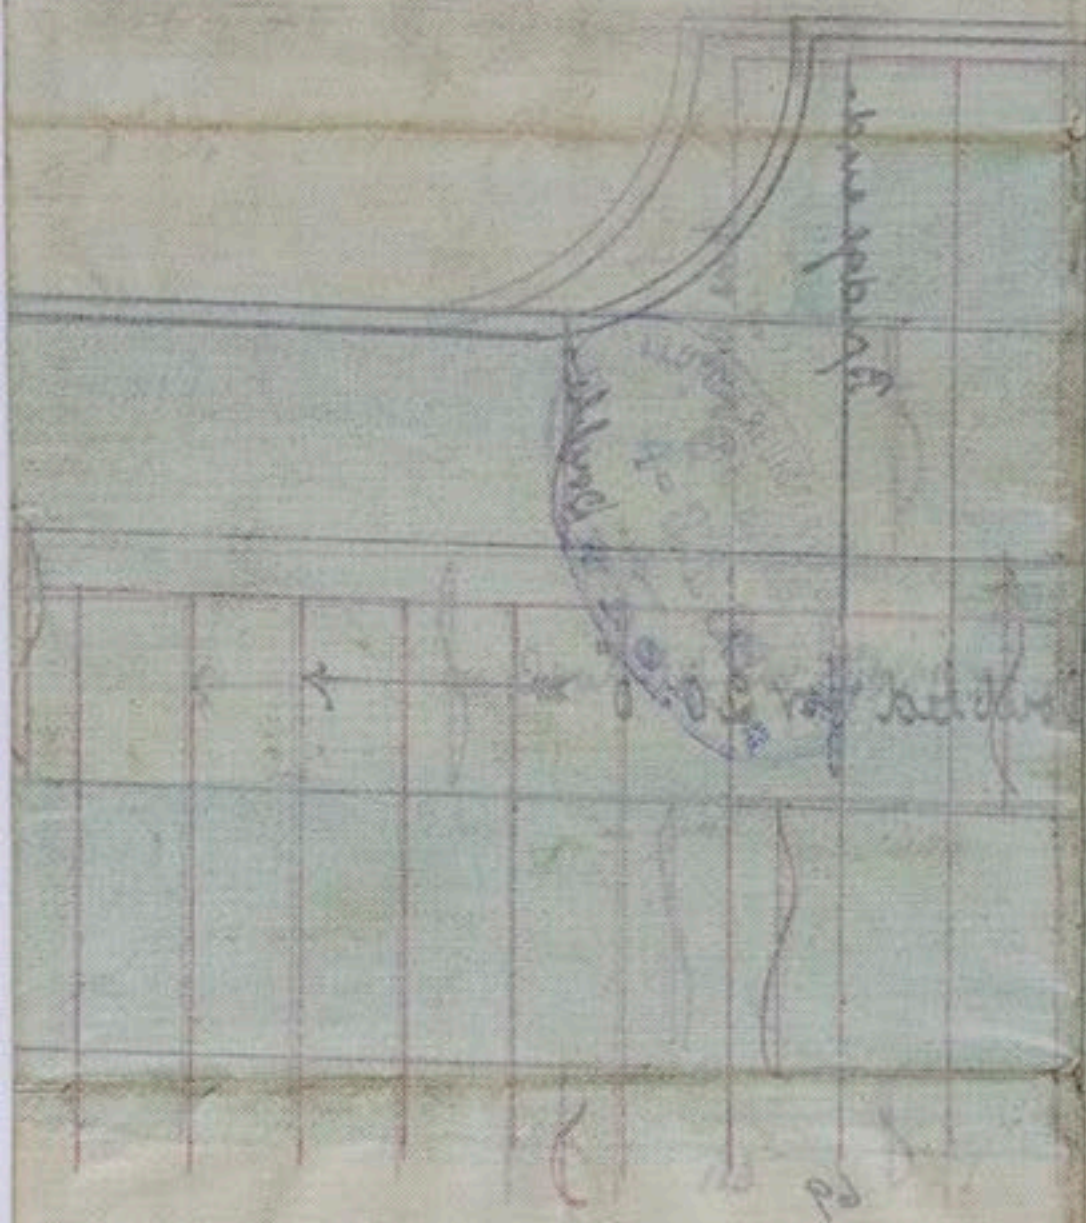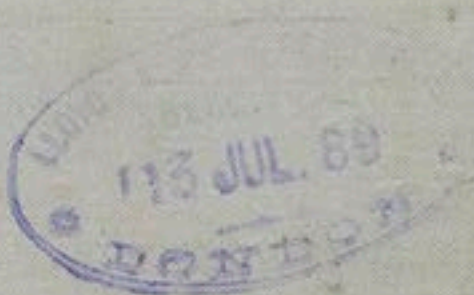

© 2018

Lloyd's Register  
Foundation

M 615 740/79