


Dimensions

Length pp	320 - 0
Breadth moulded	42 - 0
Depth md to Spar D ^s	28 - 0
" " " "	20 - 4 1/2
of Aold	19 - 3

Oil Skimmer
— S. S. No. 20 —
Midship Section
— Class 100 A1 Lloyds —
— Scale 1/2 in. One Ft. —

Numerals
 1/2 Beam 21-00
 1/2 Girth 37-66
 Depth 21-26
 19-91 Frame N°
 Length 318-33 x 49-91 = 25451 plating N°
 Breadths 7-57
 Depths 14-9
Equipment N° 30298

Allegheny

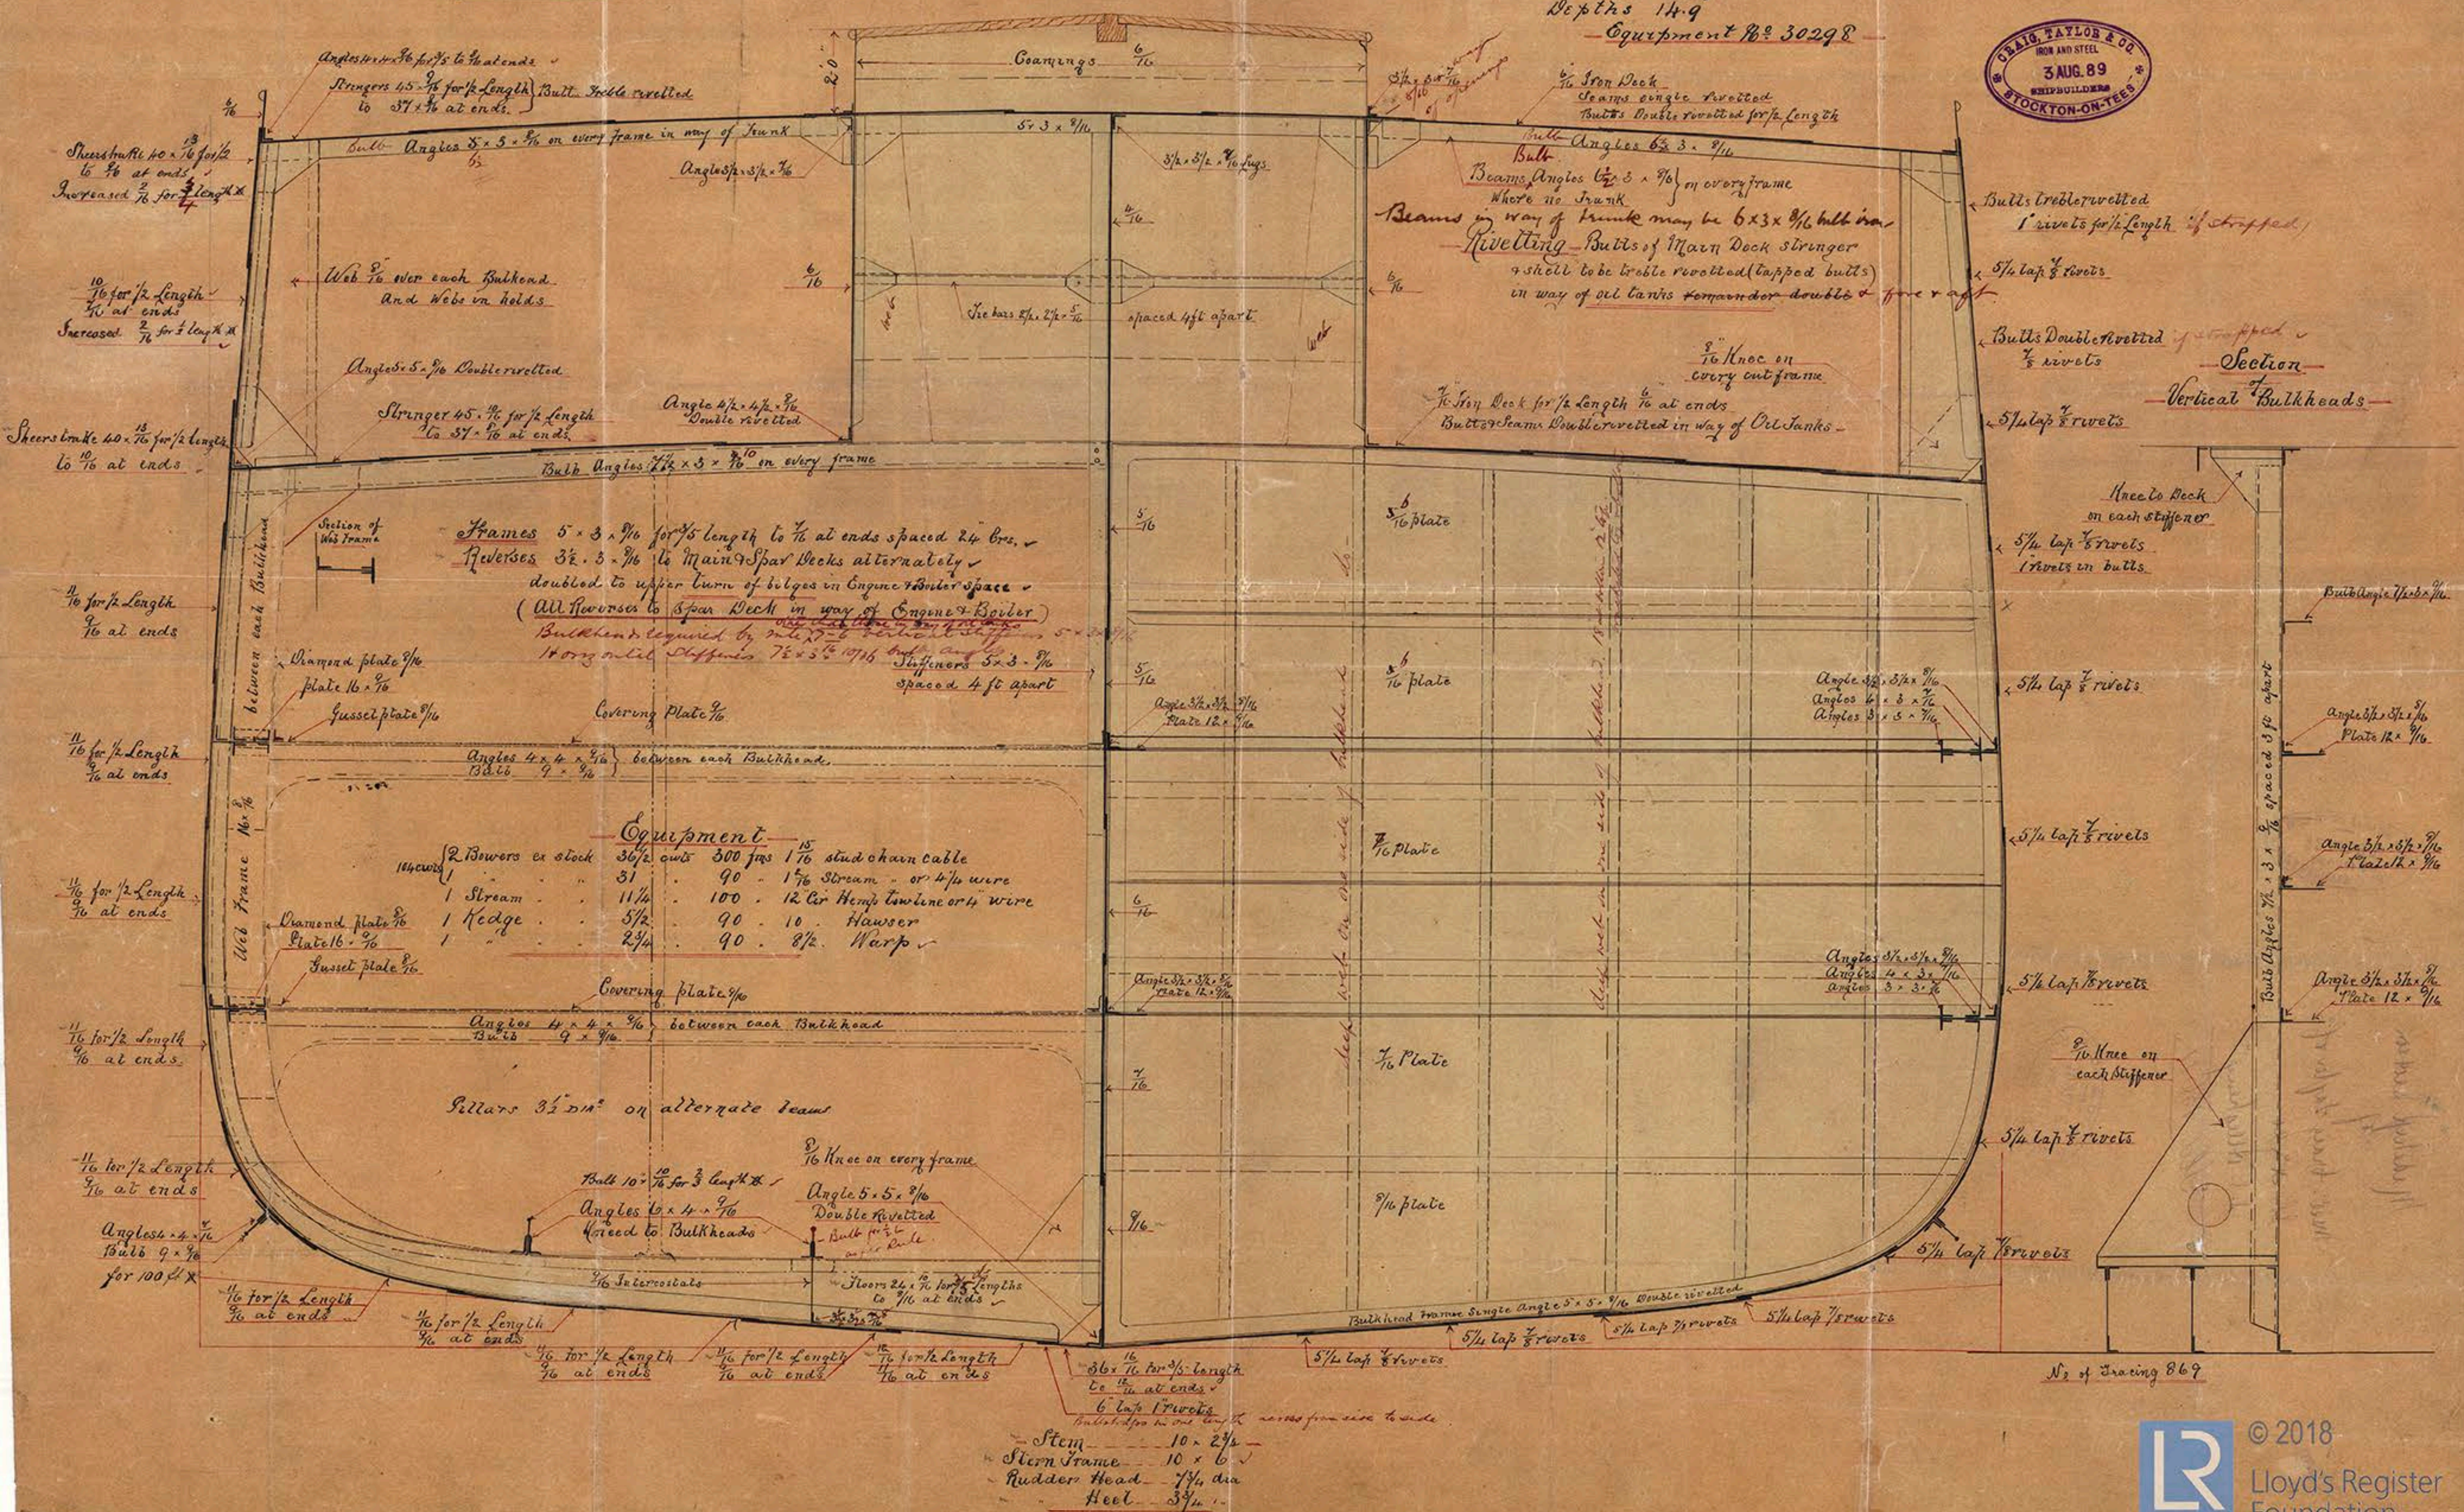

MDB740/40



Midship Section

mess^{rs}. Craig Taylor & Co

S.S. No. 20

S.S. "Allegheny"

Sld 15611

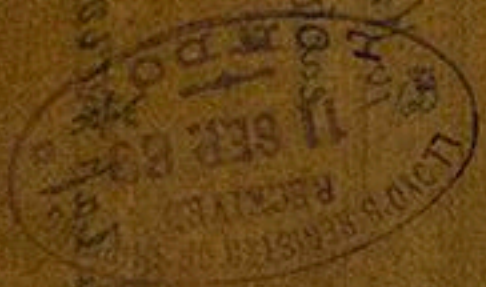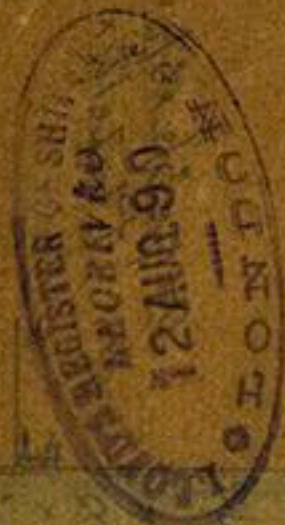

© 2018

Lloyd's Register
Foundation