


THU 15 AUG 89
SAT 14 SEP 89
MON 26 NOV 89

Note: Arrangements in way of
No. 1 oil tank to be
according to rules.

for ship
Longitudinal Section
Scale 1 inch = 1 foot

S. S. No. 20
Longitudinal Section
Scale 1 inch = 1 foot

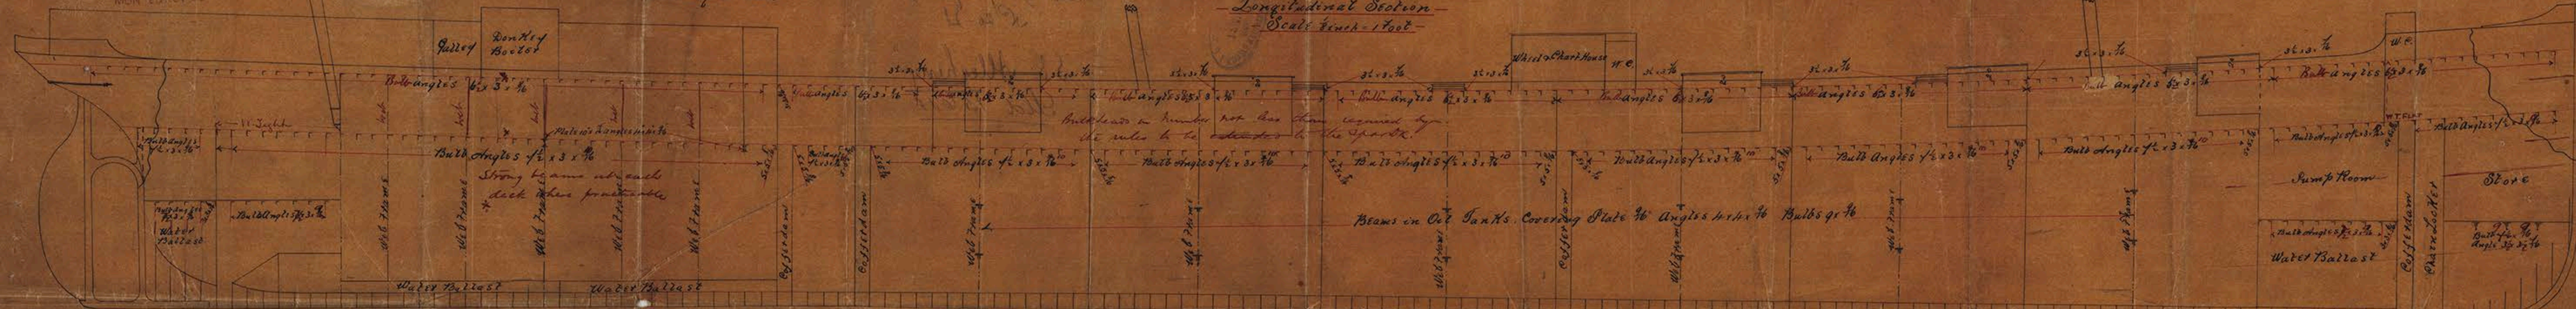


all rivets frames
to spar on

Spar Deck

Stringer $4 \times 5 \times \frac{1}{2}$ for $\frac{1}{2}$ Length to $37 \times \frac{1}{2}$ at Ends

$\frac{1}{2}$ Iron Deck

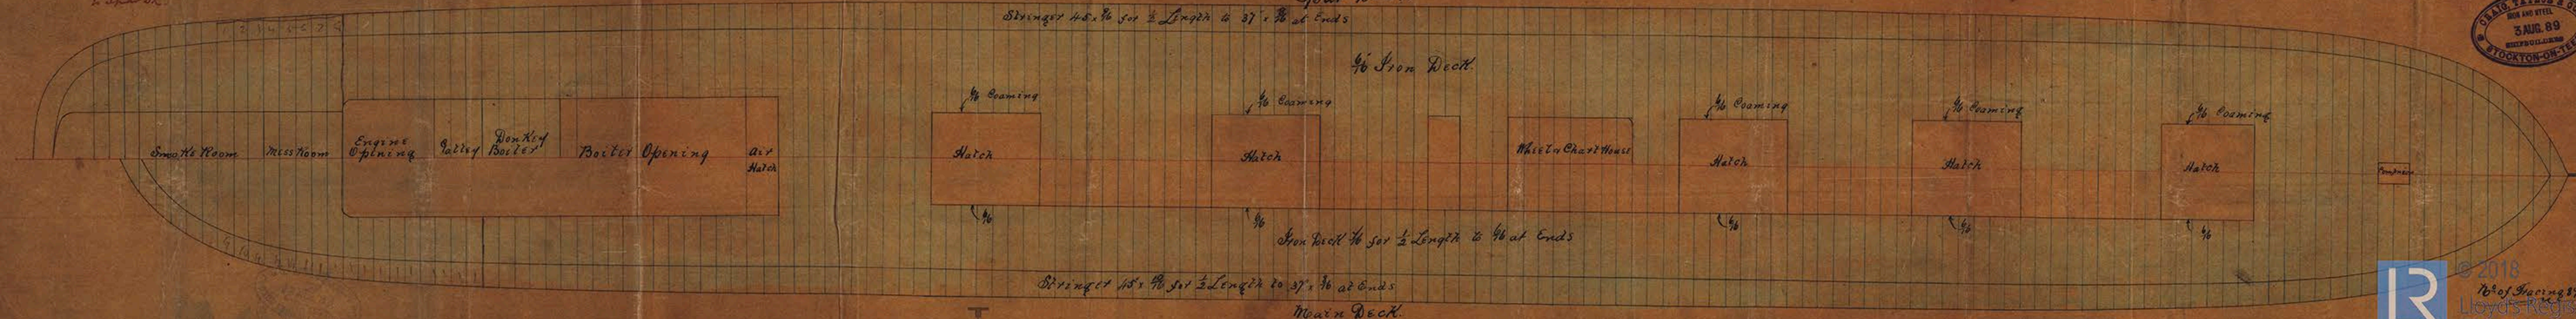

Iron Deck $\frac{1}{2}$ for $\frac{1}{2}$ Length to $\frac{1}{2}$ at Ends


Stringer $1 \times 5 \times \frac{1}{2}$ for $\frac{1}{2}$ Length to $37 \times \frac{1}{2}$ at Ends

Main Deck



© 2018
16 of 16 pages 8/10
Lloyd's Register
Foundation

Profile of
Mrs. Craig Taylor & Co.
No 20 St

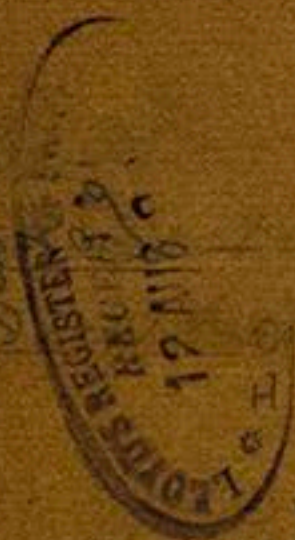

S.S. Allegheny
Gld 15611

