
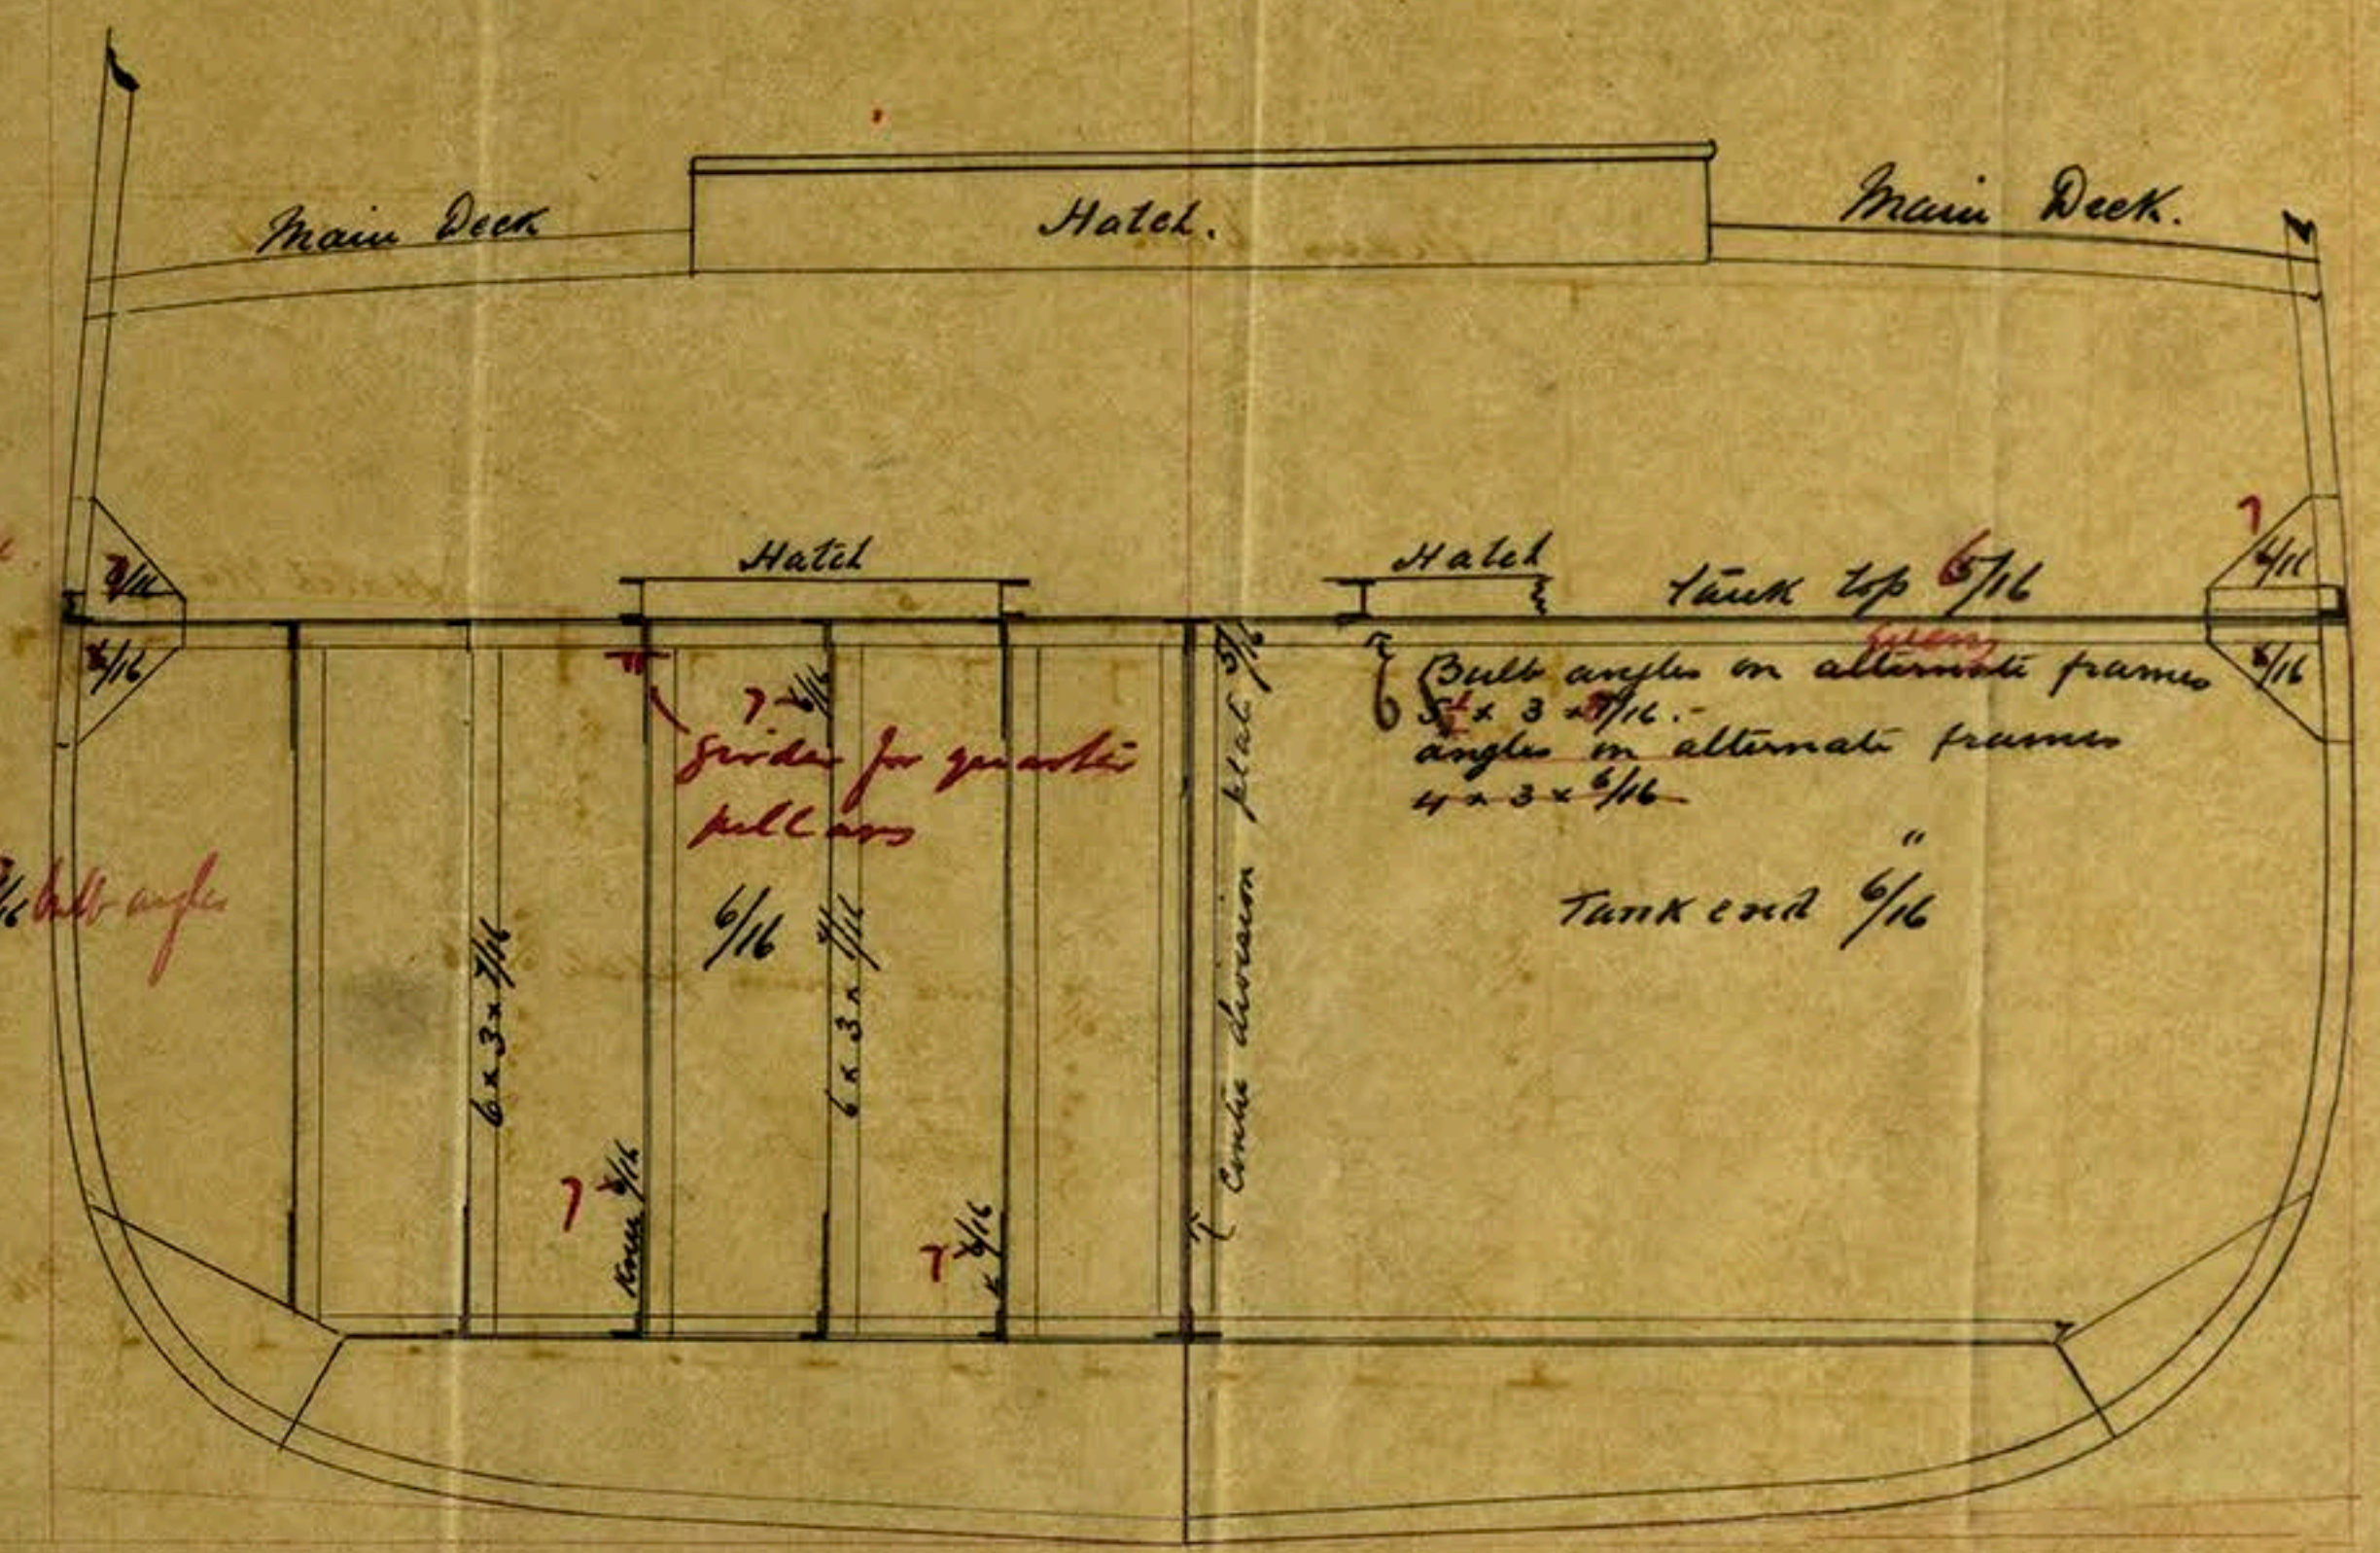



PP104588M

Half tank depth
not
increased. i.e.
increased

MON 30 JUN 90

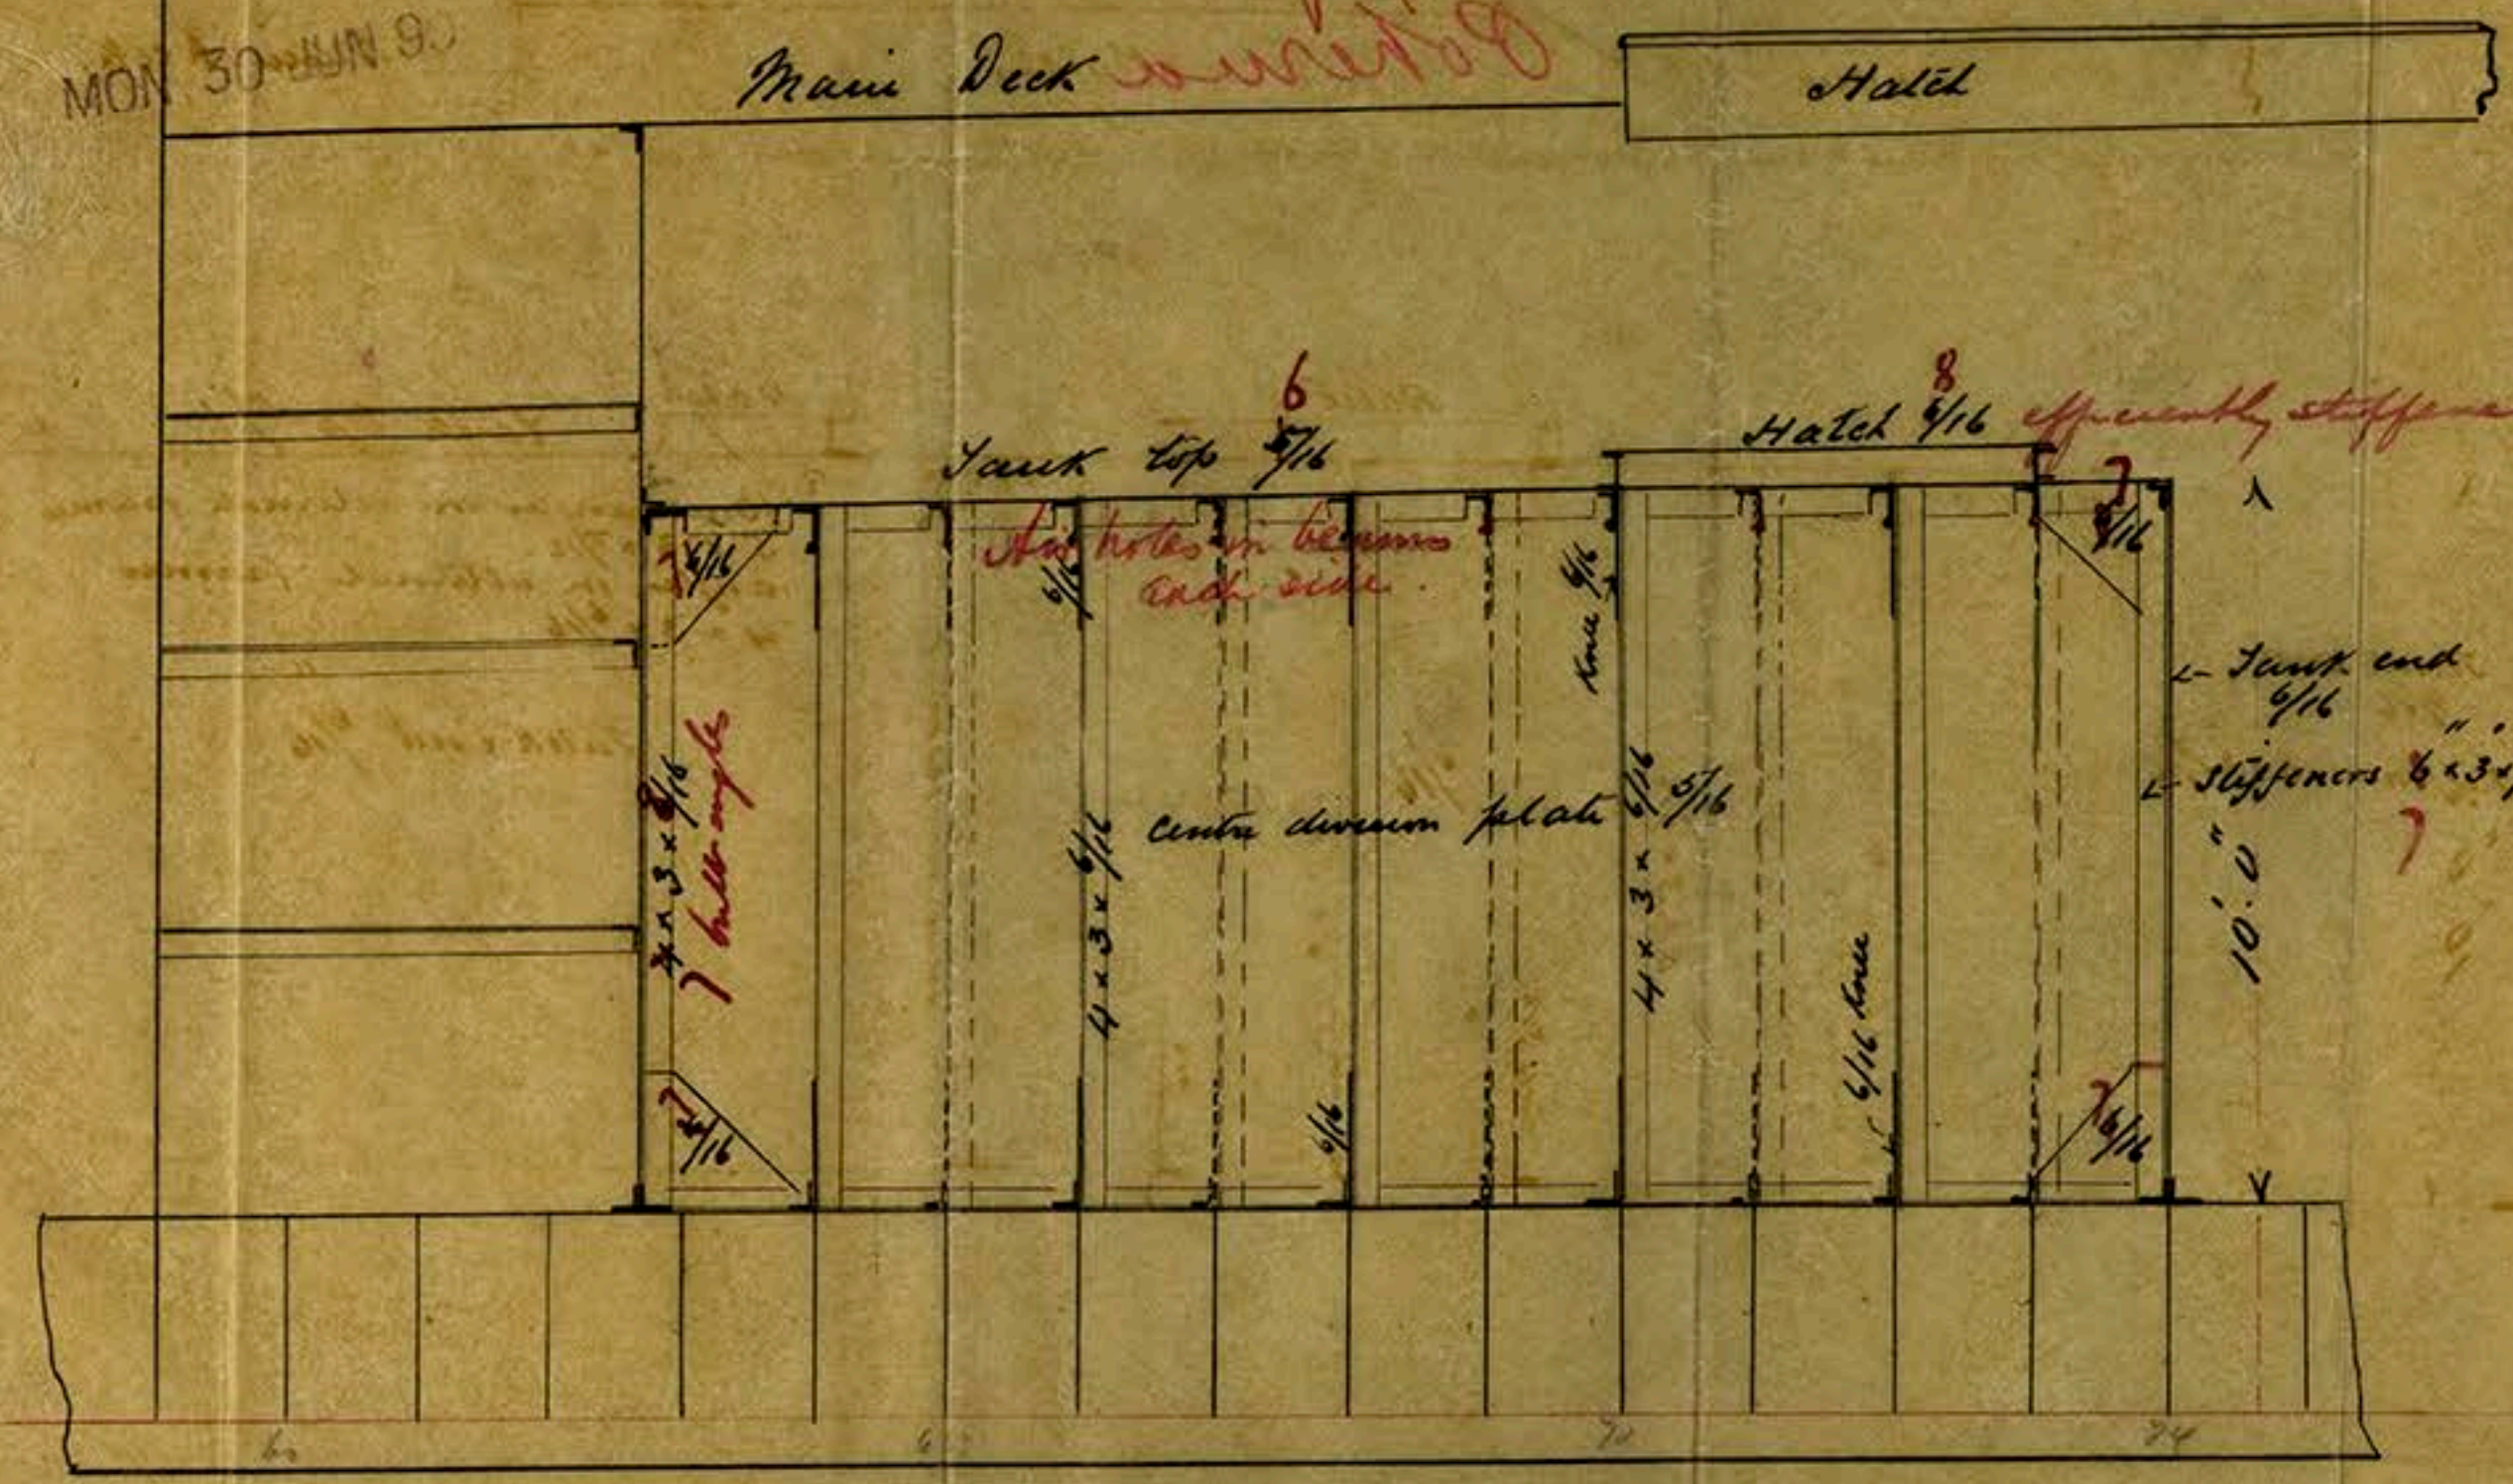

25
12
5
2
9
10

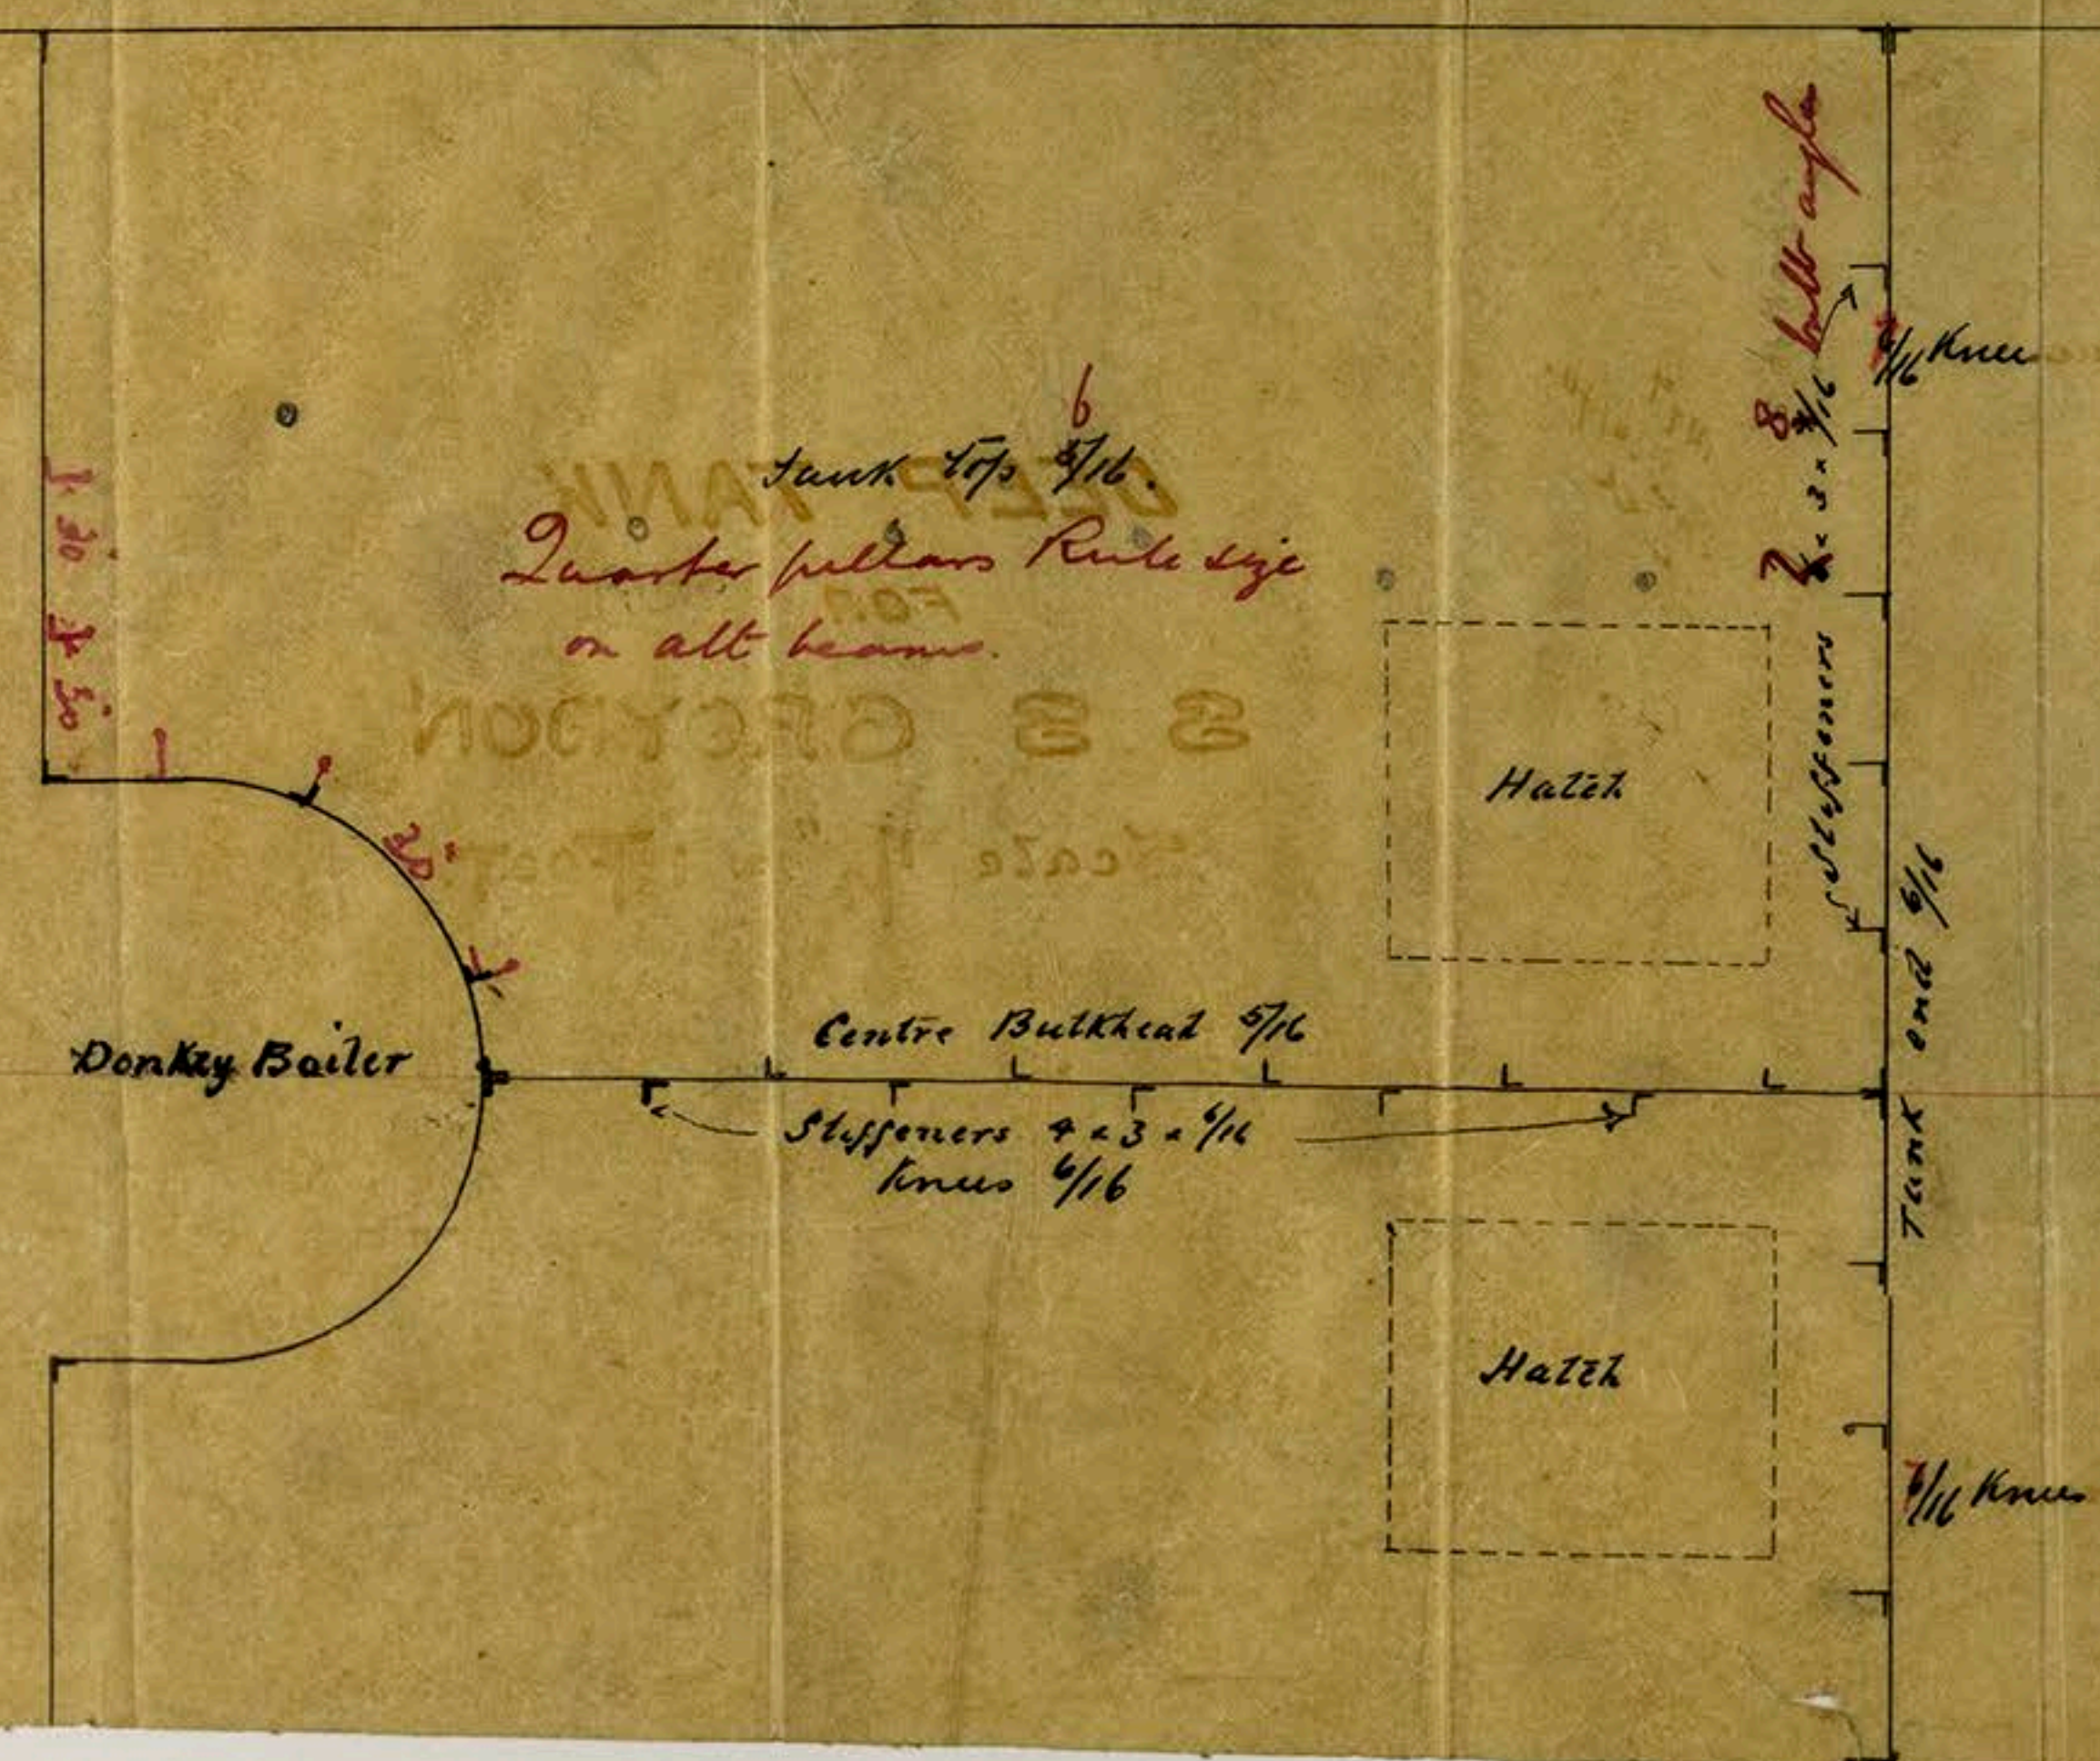

DEEP TANK
FOR
S. S. GROYNON
Scale $\frac{1}{4}" = 1 \text{ FOOT}$



25/6/90

21 m m
no 690