

S.S. Lynnhed

Received at Middlesbro office 13<sup>th</sup> August 1890

Lloyd's Register of British and Foreign Shipping.

Middlesbro (Report on Vessel No. 194 Port Mbro)

No. 1574a SHIP FORGINGS OR CASTINGS.

I have to report that the undermentioned Iron or Steel Forgings or Castings, manufactured by the Stokton Forge Co. of Stokton for the Vessel No. 250, being built by Messrs Roper & Sons of Stokton have been inspected by me as set forth below, and found to be, so far as can be seen, sound

The words FORGINGS or CASTINGS, IRON or STEEL, should be struck out as may be required.


Mark on Forgings.

Lloyd's No. 1574a 20.6.

Rough Cannon. Sunderland 18" 8" 90

Table with 4 columns: Material, How made, Dimensions, Progress on Inspection, Dates when Inspected. Rows for STERN FRAME, RUDDER FRAME, and STEM.

SKETCHES OF FRAMES SHEWING POSITION AND DESCRIPTION OF WELDS OF FORGINGS, OR PARTICULARS OF TESTS APPLIED TO CASTINGS.

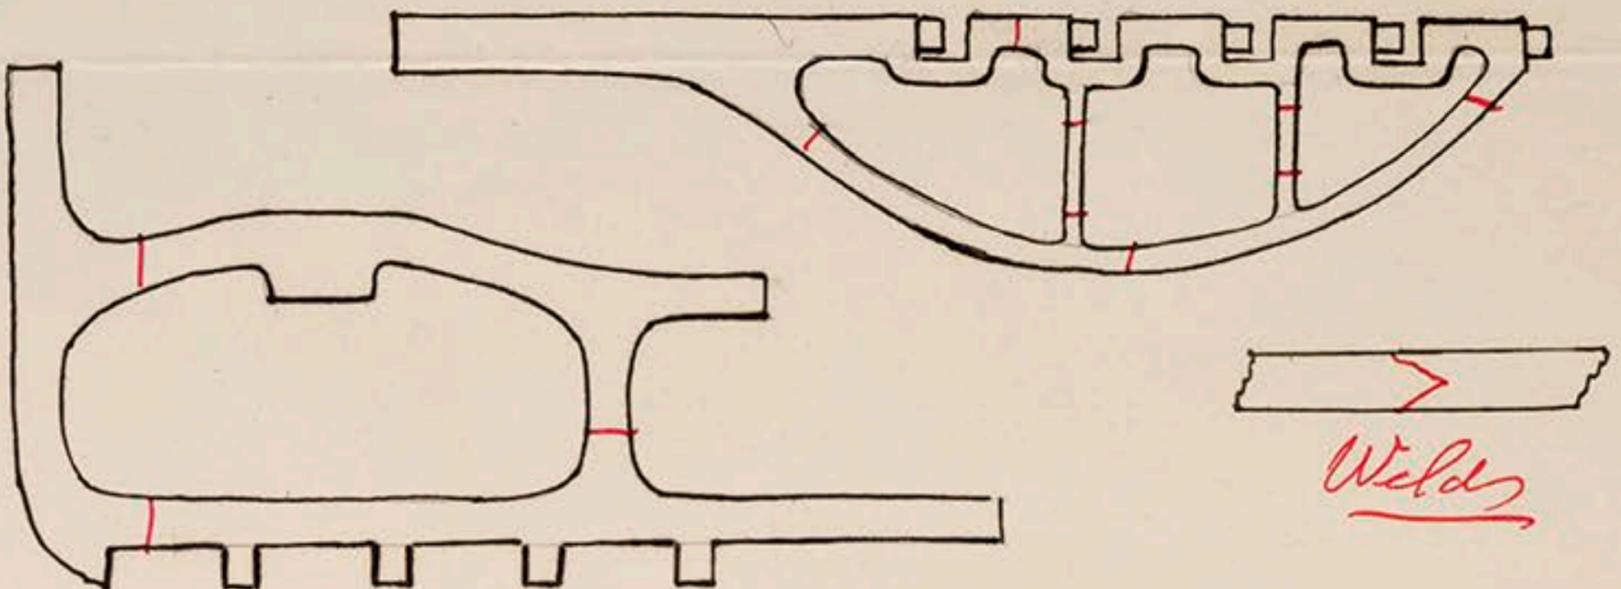

Welds

\* If of Iron, state whether scrap or puddled Iron.



© 2018

Lloyd's Register Foundation