



Ln: 16. 12. 89.

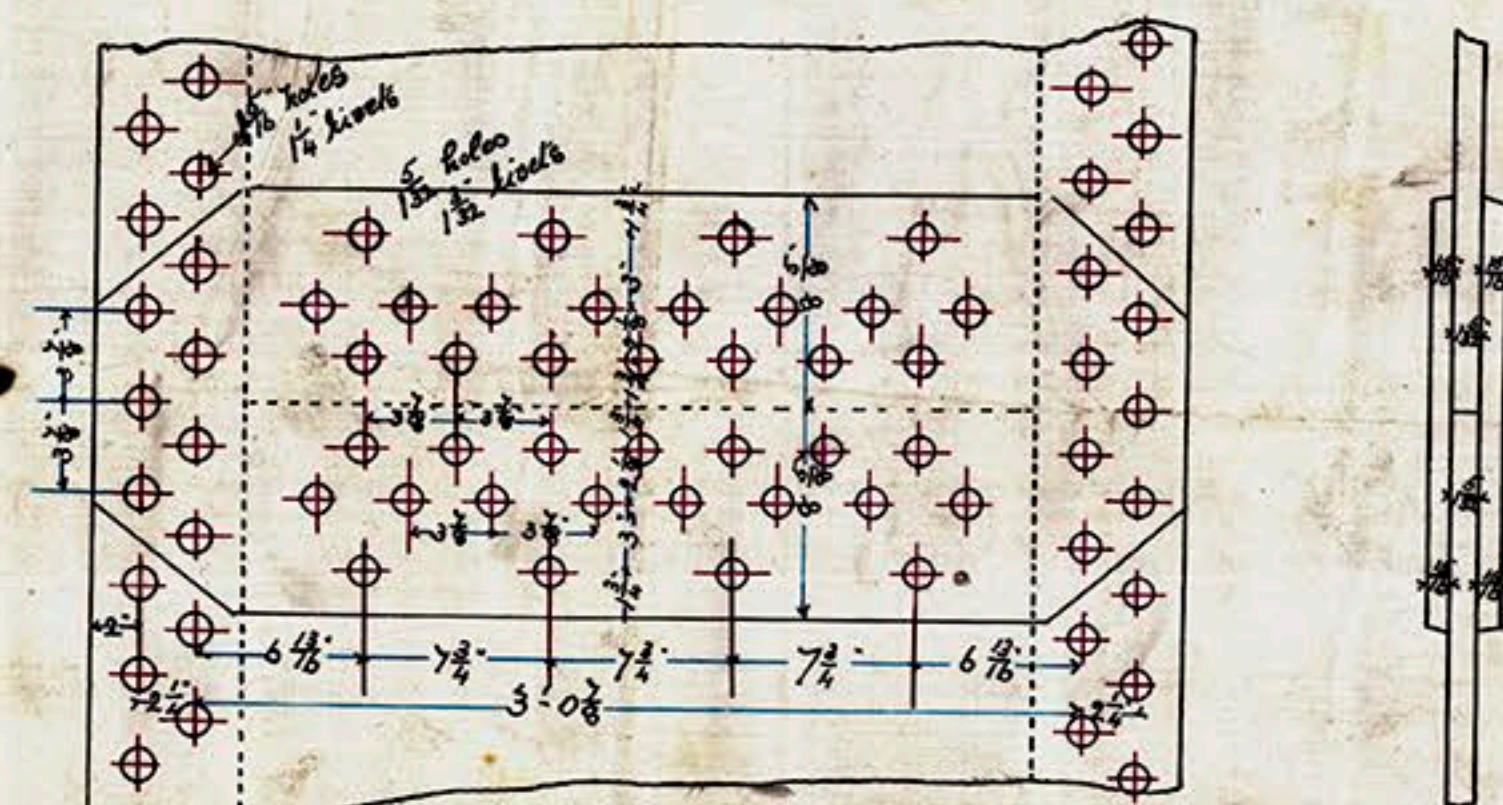

— Detail of butt joint. Scale  $1\frac{1}{2}'' = 1 \text{ Foot}$

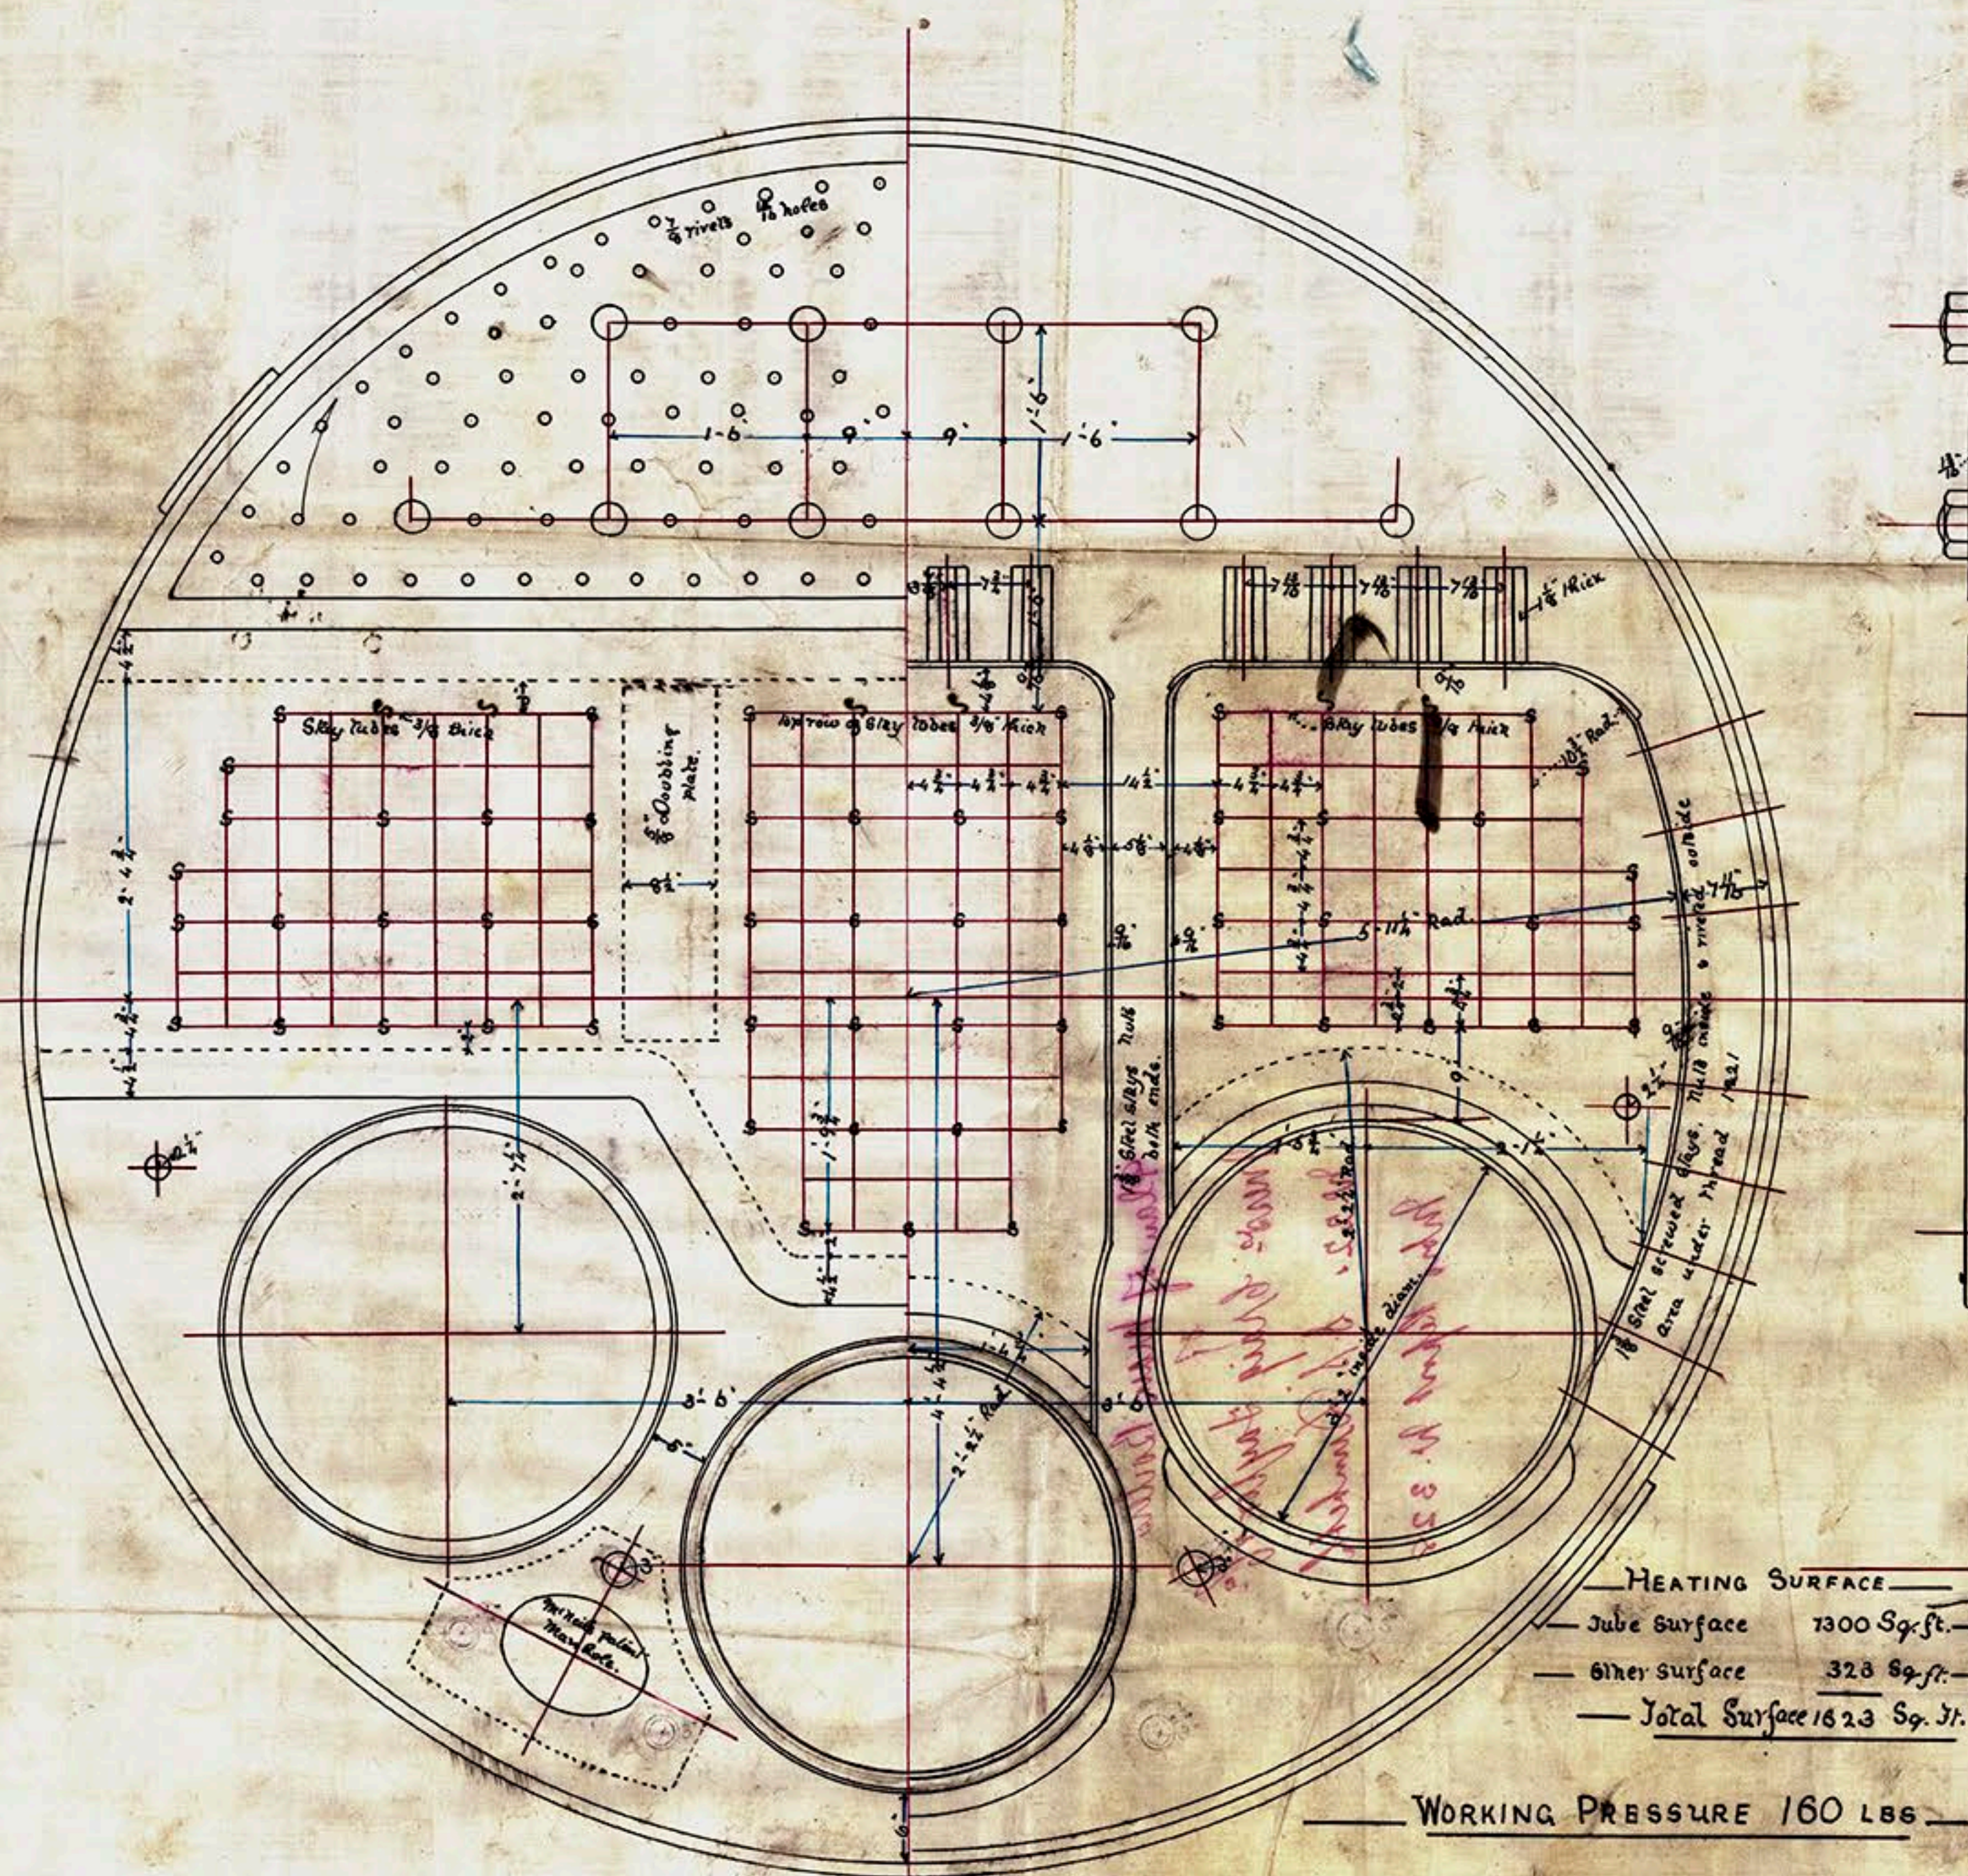

2 STEEL BOILERS

Scale 1"=1 foot.


N<sup>o</sup> 111

Coran Nov. 27<sup>th</sup> 1889

MS.  
16.12.80





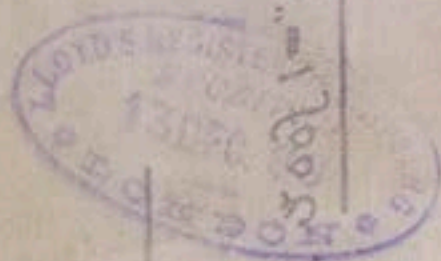


# NO III STEEL BOILERS

General Description

WORKING PRESSURE 160 lbs

- HEATING SURFACE —

Plan of Main Boilers  
of  
Messrs Craig Taylor & Co.  
No. 22, S. S. Dumbeth  
Intro Report No. 328

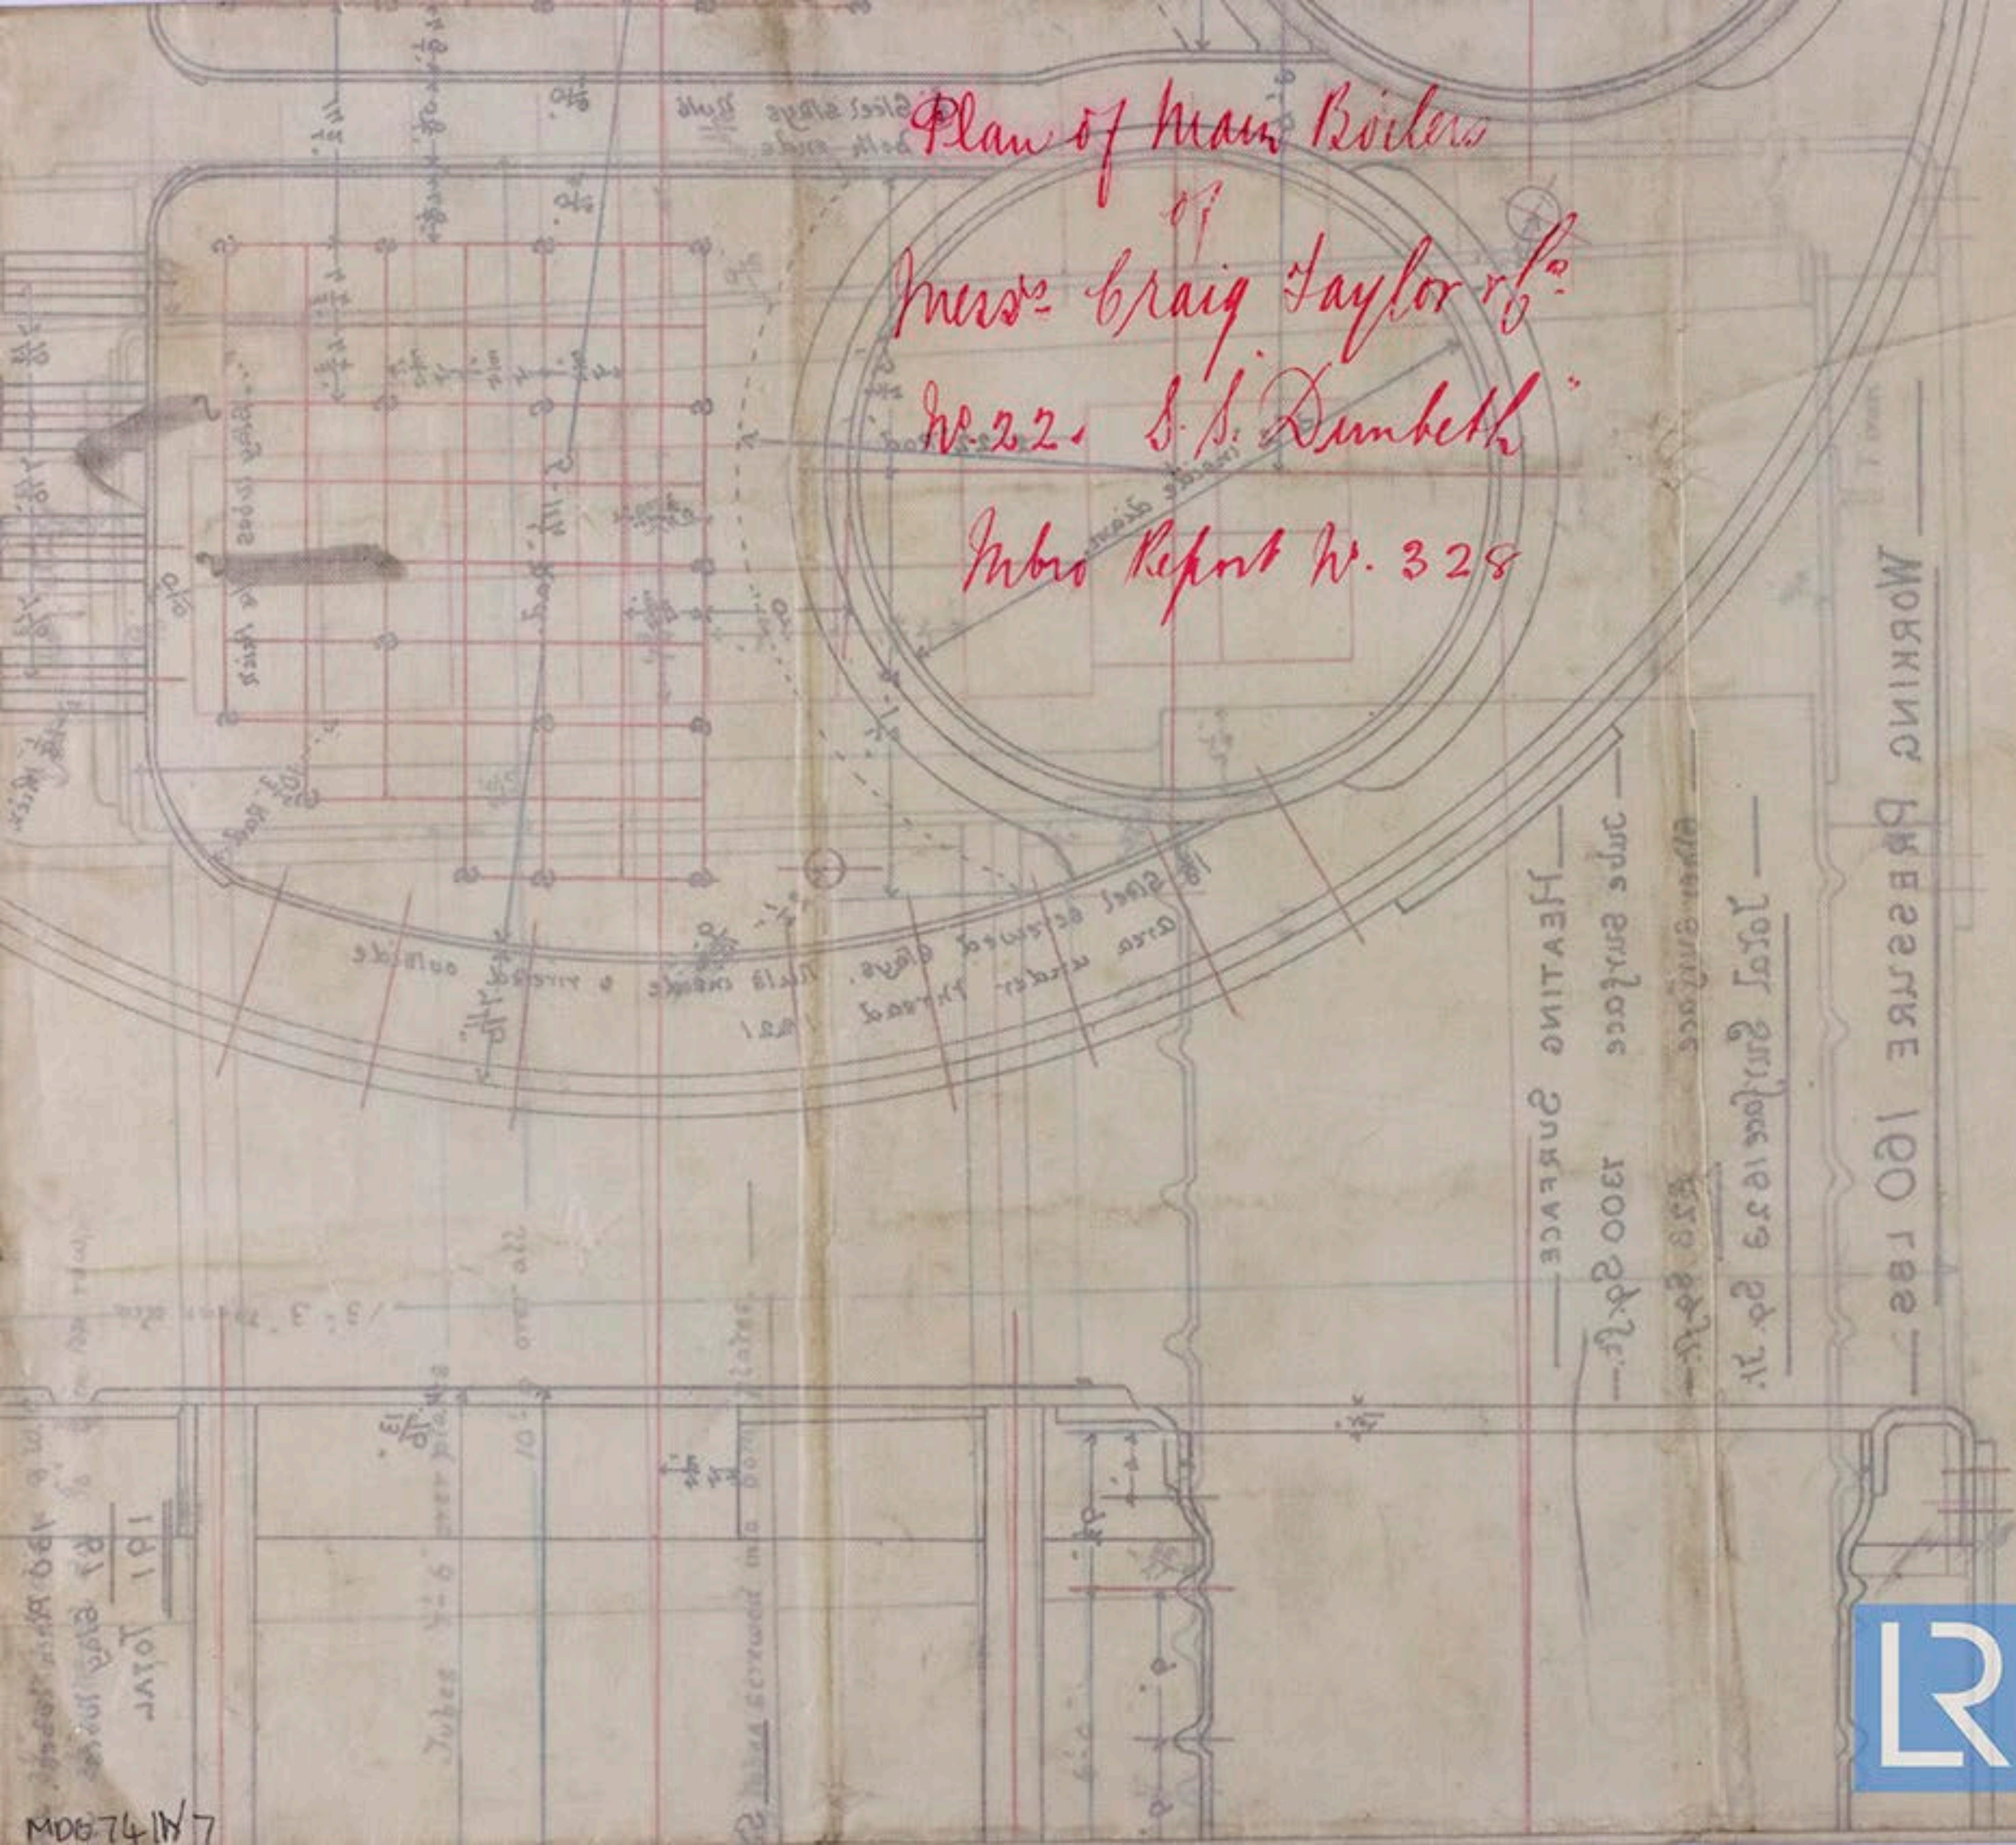

© 2018  
Lloyd's Register  
Foundation