

S. J. Daybreak

Received at Middlesboro office. 26th November 18 90

Lloyd's Register of British and Foreign Shipping.

Middlesboro (Report on Vessel No. 329 Port Mboro)

No. 1780a. SHIP FORGINGS OR CASTINGS.

I have to report that the undermentioned Iron or Steel Forgings or Castings, manufactured by

The Stockton Forge Co. of Stockton

for the Vessel No. 255, being built by Messrs. Roper & Sons

of Stockton have been inspected by me as set forth below, and found

to be, so far as can be seen, sound

Mark on Forgings.

Lloyd's
No. 1780a
etc. etc.


Hugh Cameron

Sunderland.

25. 11. 90.

	STERN FRAME.	RUDDER FRAME.	STEM.
Material*	<u>Scrap iron</u>	<u>Scrap iron</u>	<u>Scrap iron</u>
How made	<u>Forged</u>	<u>Forged</u>	<u>Forged</u>
Dimensions	<u>10' x 6'</u>	<u>8' - 4"</u>	<u>10' x 2 3/4'</u>
Progress on Inspection	<u>Inspected</u>	<u>Forged Inspected</u>	<u>Forged</u>
Dates when Inspected	<u>Aug 8 26-29 Sept 5/90</u>	<u>Oct 10-17-21-30 Nov 4</u> <u>7-10-18/90</u>	<u>Nov 4/90</u>

SKETCHES OF FRAMES SHEWING POSITION AND DESCRIPTION OF WELDS OF FORGINGS, OR PARTICULARS OF TESTS APPLIED TO CASTINGS.

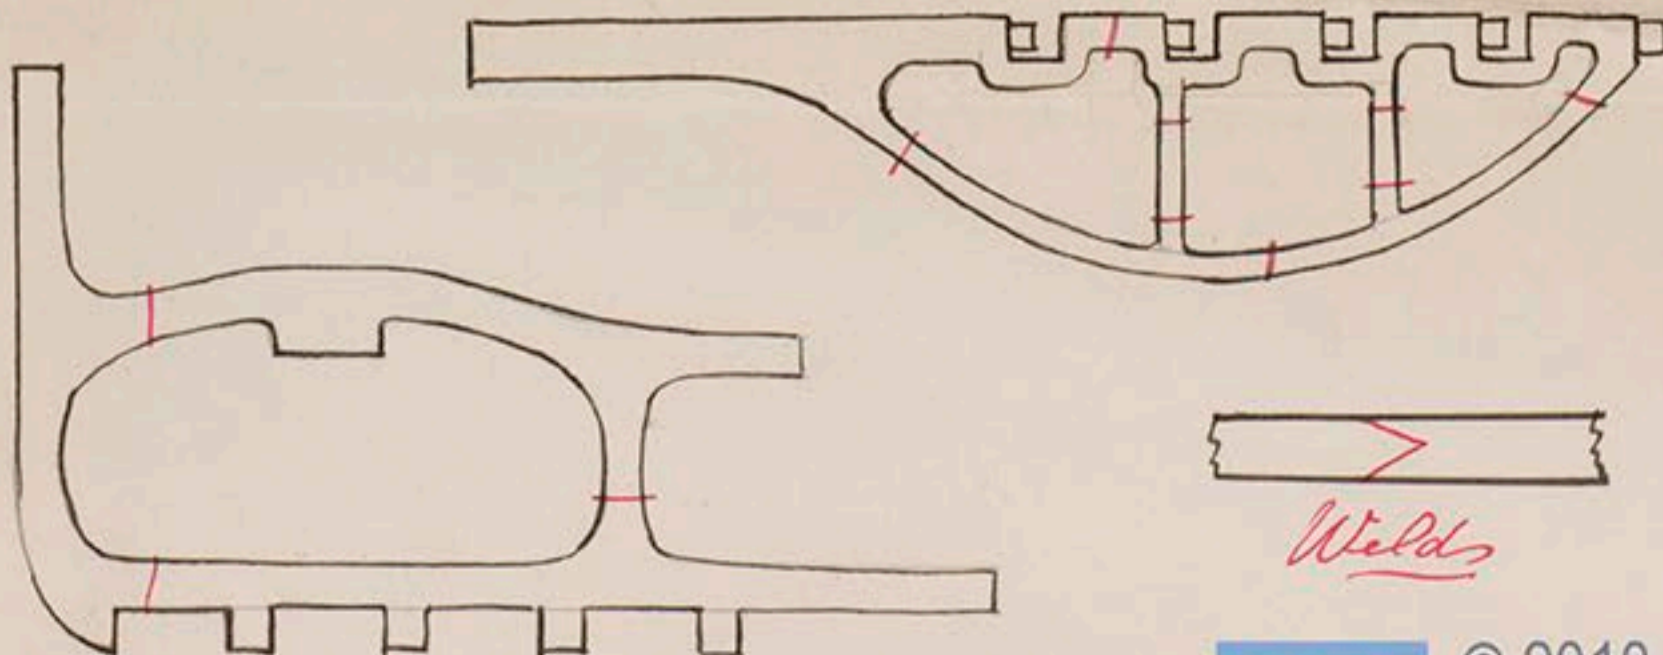

* If of Iron, state whether scrap or puddled iron.