


date: 22.10.90

Pumping Arrangement No. 382

Scale $\frac{1}{2}$ in. to 1 ft.

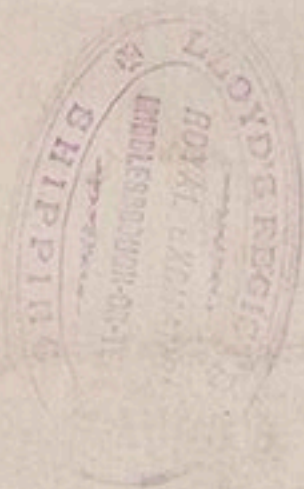

Pumping Plan
Richardson Buck & Co
S.S. No 382

S.S. "Sledmere"
Intro Report No 345



© 2018

Lloyd's Register
Foundation