

S.S. "Sledmere"

Received at Middlesbrough Office, 8<sup>th</sup> January 1891

# Lloyd's Register of British and Foreign Shipping.

Middlesbrough (Report on Vessel No. 345 Port London)

## No. 1783.a SHIP FORGINGS OR CASTINGS.

I have to report that the undermentioned Iron or Steel Forgings or Castings, manufactured by The Stockton Forge Co. of Stockton for the Vessel No. 382, being built by Messrs Richardson Duck & Co. of Stockton have been inspected by me as set forth below, and found to be, so far as can be seen, sound.

The words, FORGINGS or CASTINGS, IRON or STEEL, should be struck out as may be required.


Mark on Forgings.

Lloyd's  
No. 1783.a  
L.C.

*Wm Cameron*  
Linduland

	STERN FRAME.	RUDDER FRAME.	STEM.
Material*	Scrap iron	Scrap iron	
How made	Forged	Forged	
Dimensions	9' 5"	7' 3 1/2"	
Progress on Inspection	Smithed	Forged & smithed	not seen
Dates when Inspected	Oct 10/90	Nov 4-7-10-21-27-29 Dec 8-16-23/90	

SKETCHES OF FRAMES SHEWING POSITION AND DESCRIPTION OF WELDS OF FORGINGS, OR PARTICULARS OF TESTS APPLIED TO CASTINGS.

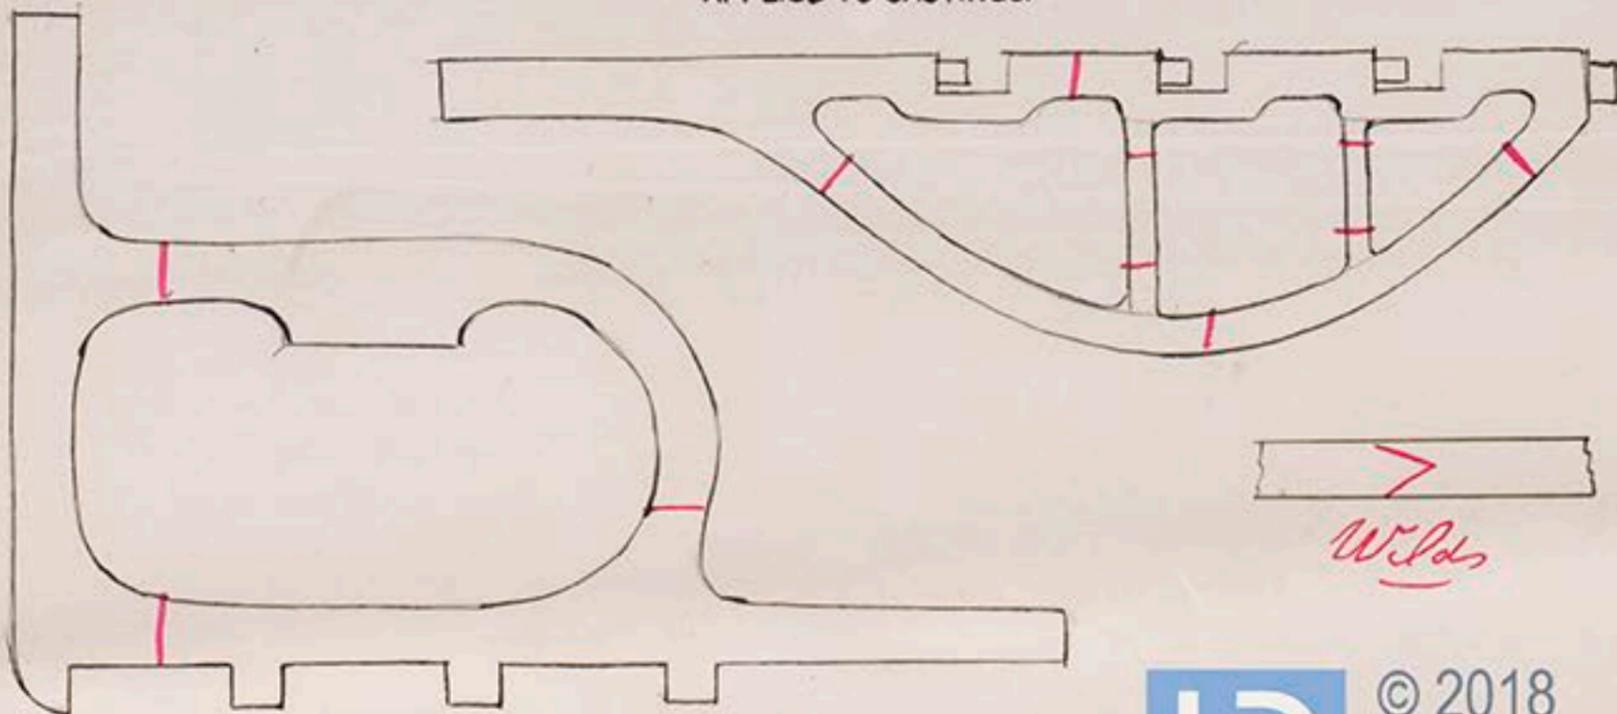

© 2018

Lloyd's Register Foundation

\* If of Iron, state whether scrap or puddled iron.

1783