


— Pintles —
— Scale $1\frac{1}{2}'' = \text{One Foot.}$

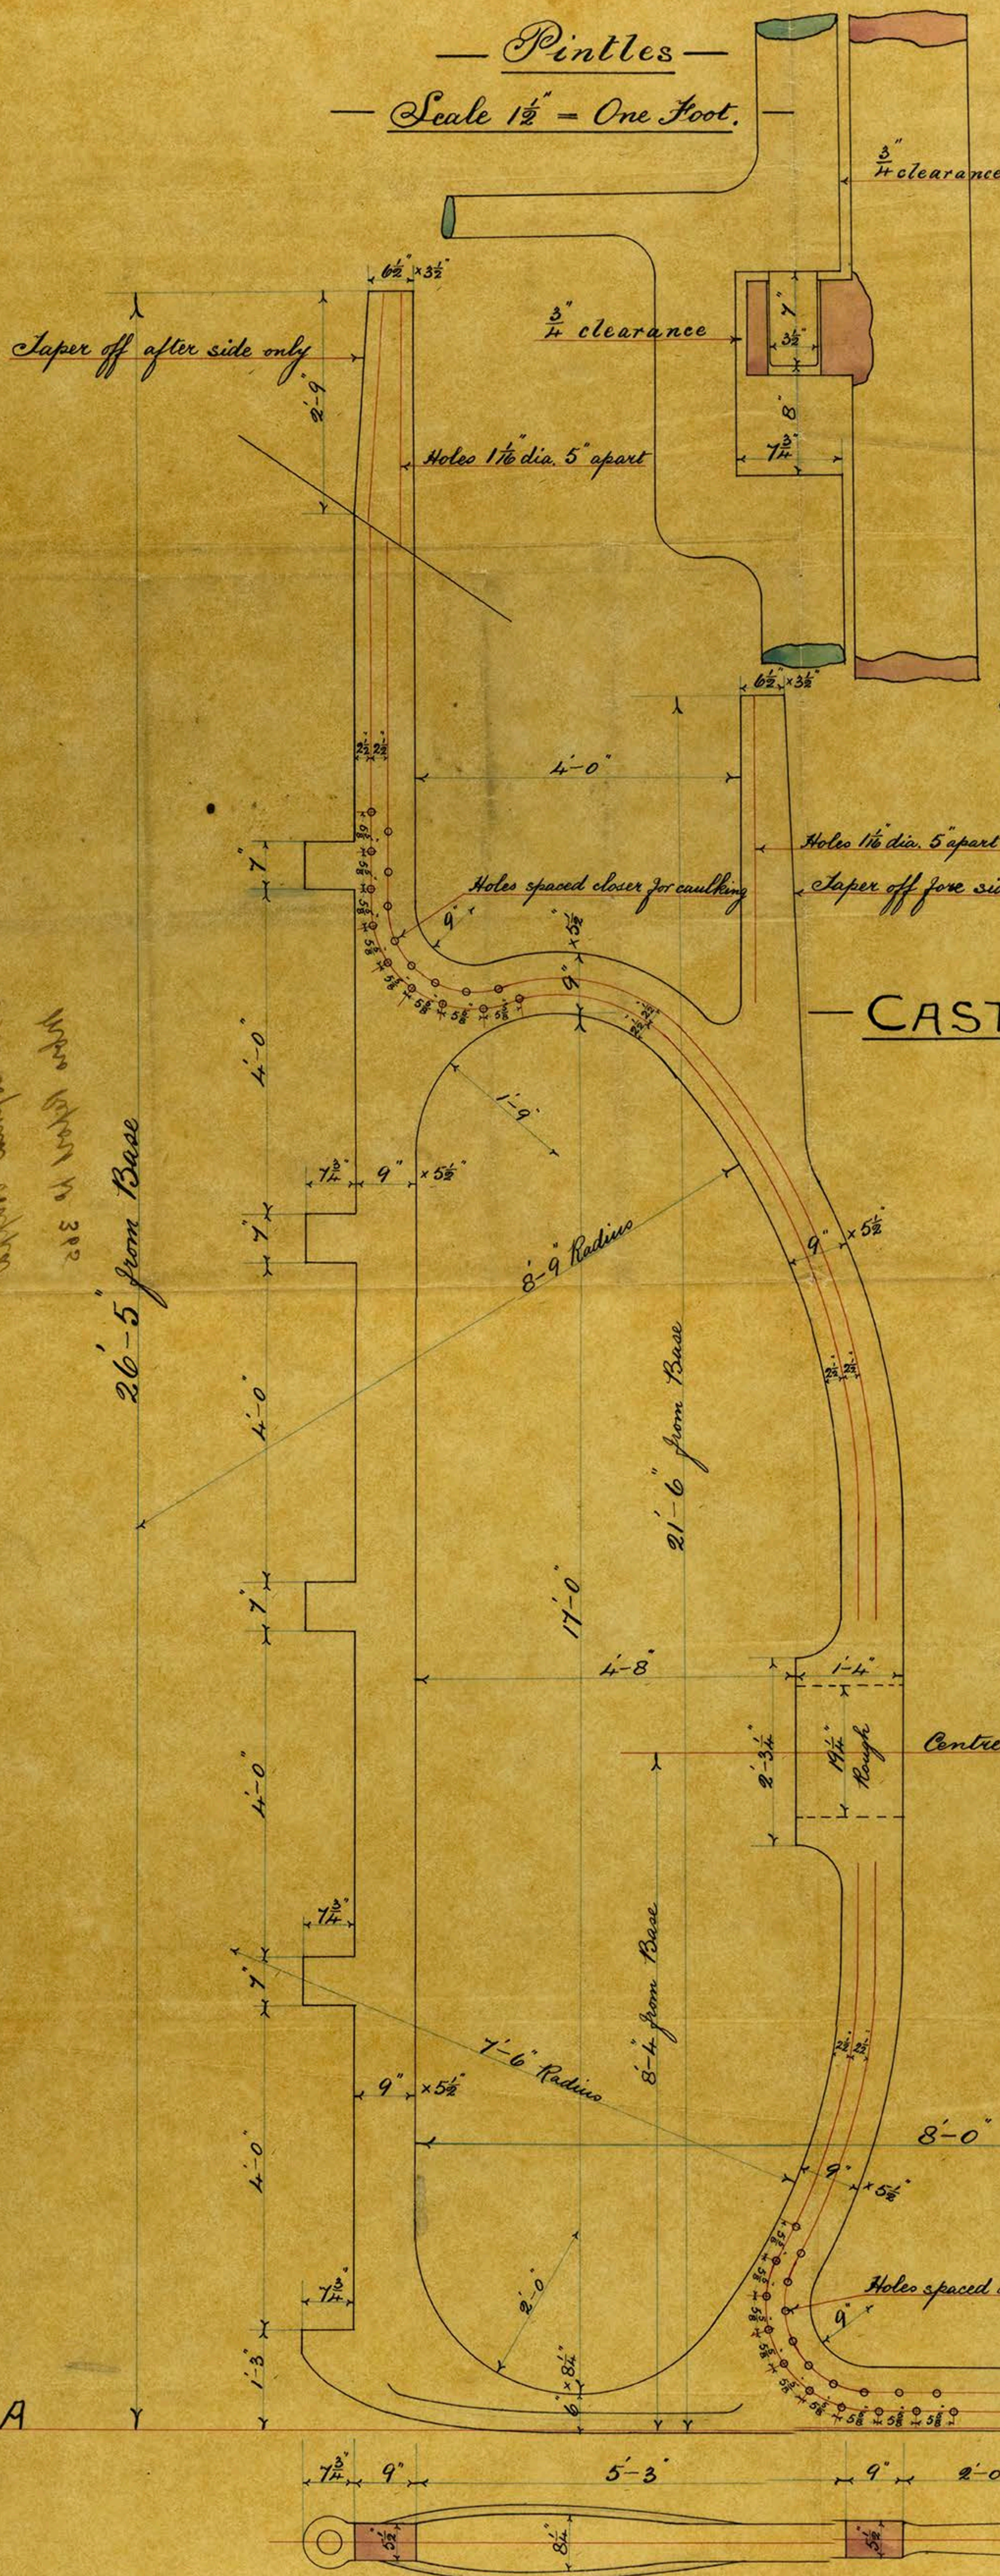



Note.—Gudgeons to be drilled to suit $3\frac{1}{2}$ " pintles
according to large sketch

Holes in Stern Frame to be drilled $1\frac{3}{8}$ " dia.
and spaced $5\frac{5}{8}$ " apart Centre to Centre
Stern Frame to be perfectly square from
Line A.B. Holes in Gudgeons to be drilled
so as Rudder Frame will clear when
swinging round.

Amended Tracing of
— CAST STEEL STERN FRAME —
— FOR S. S. N^o 25 —

— SCALE $\frac{3}{4}$ INCH = ONE FOOT —

for Messrs Craig, Taylor & Co
Stockton-on-Tees

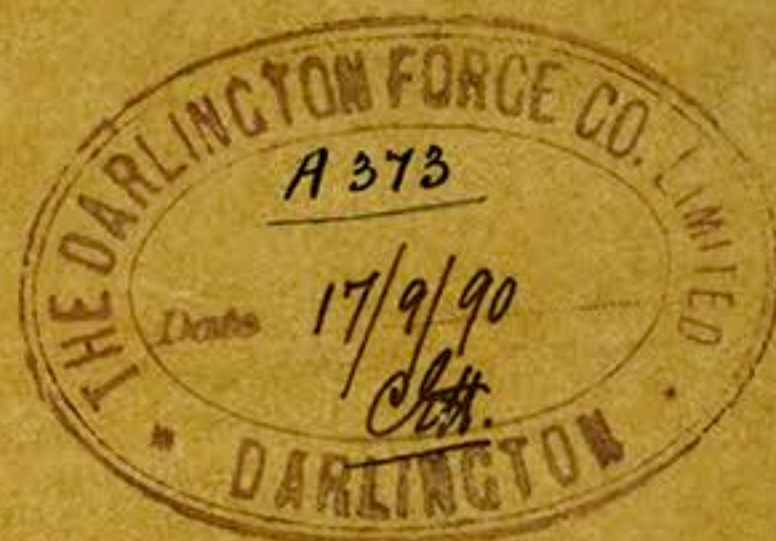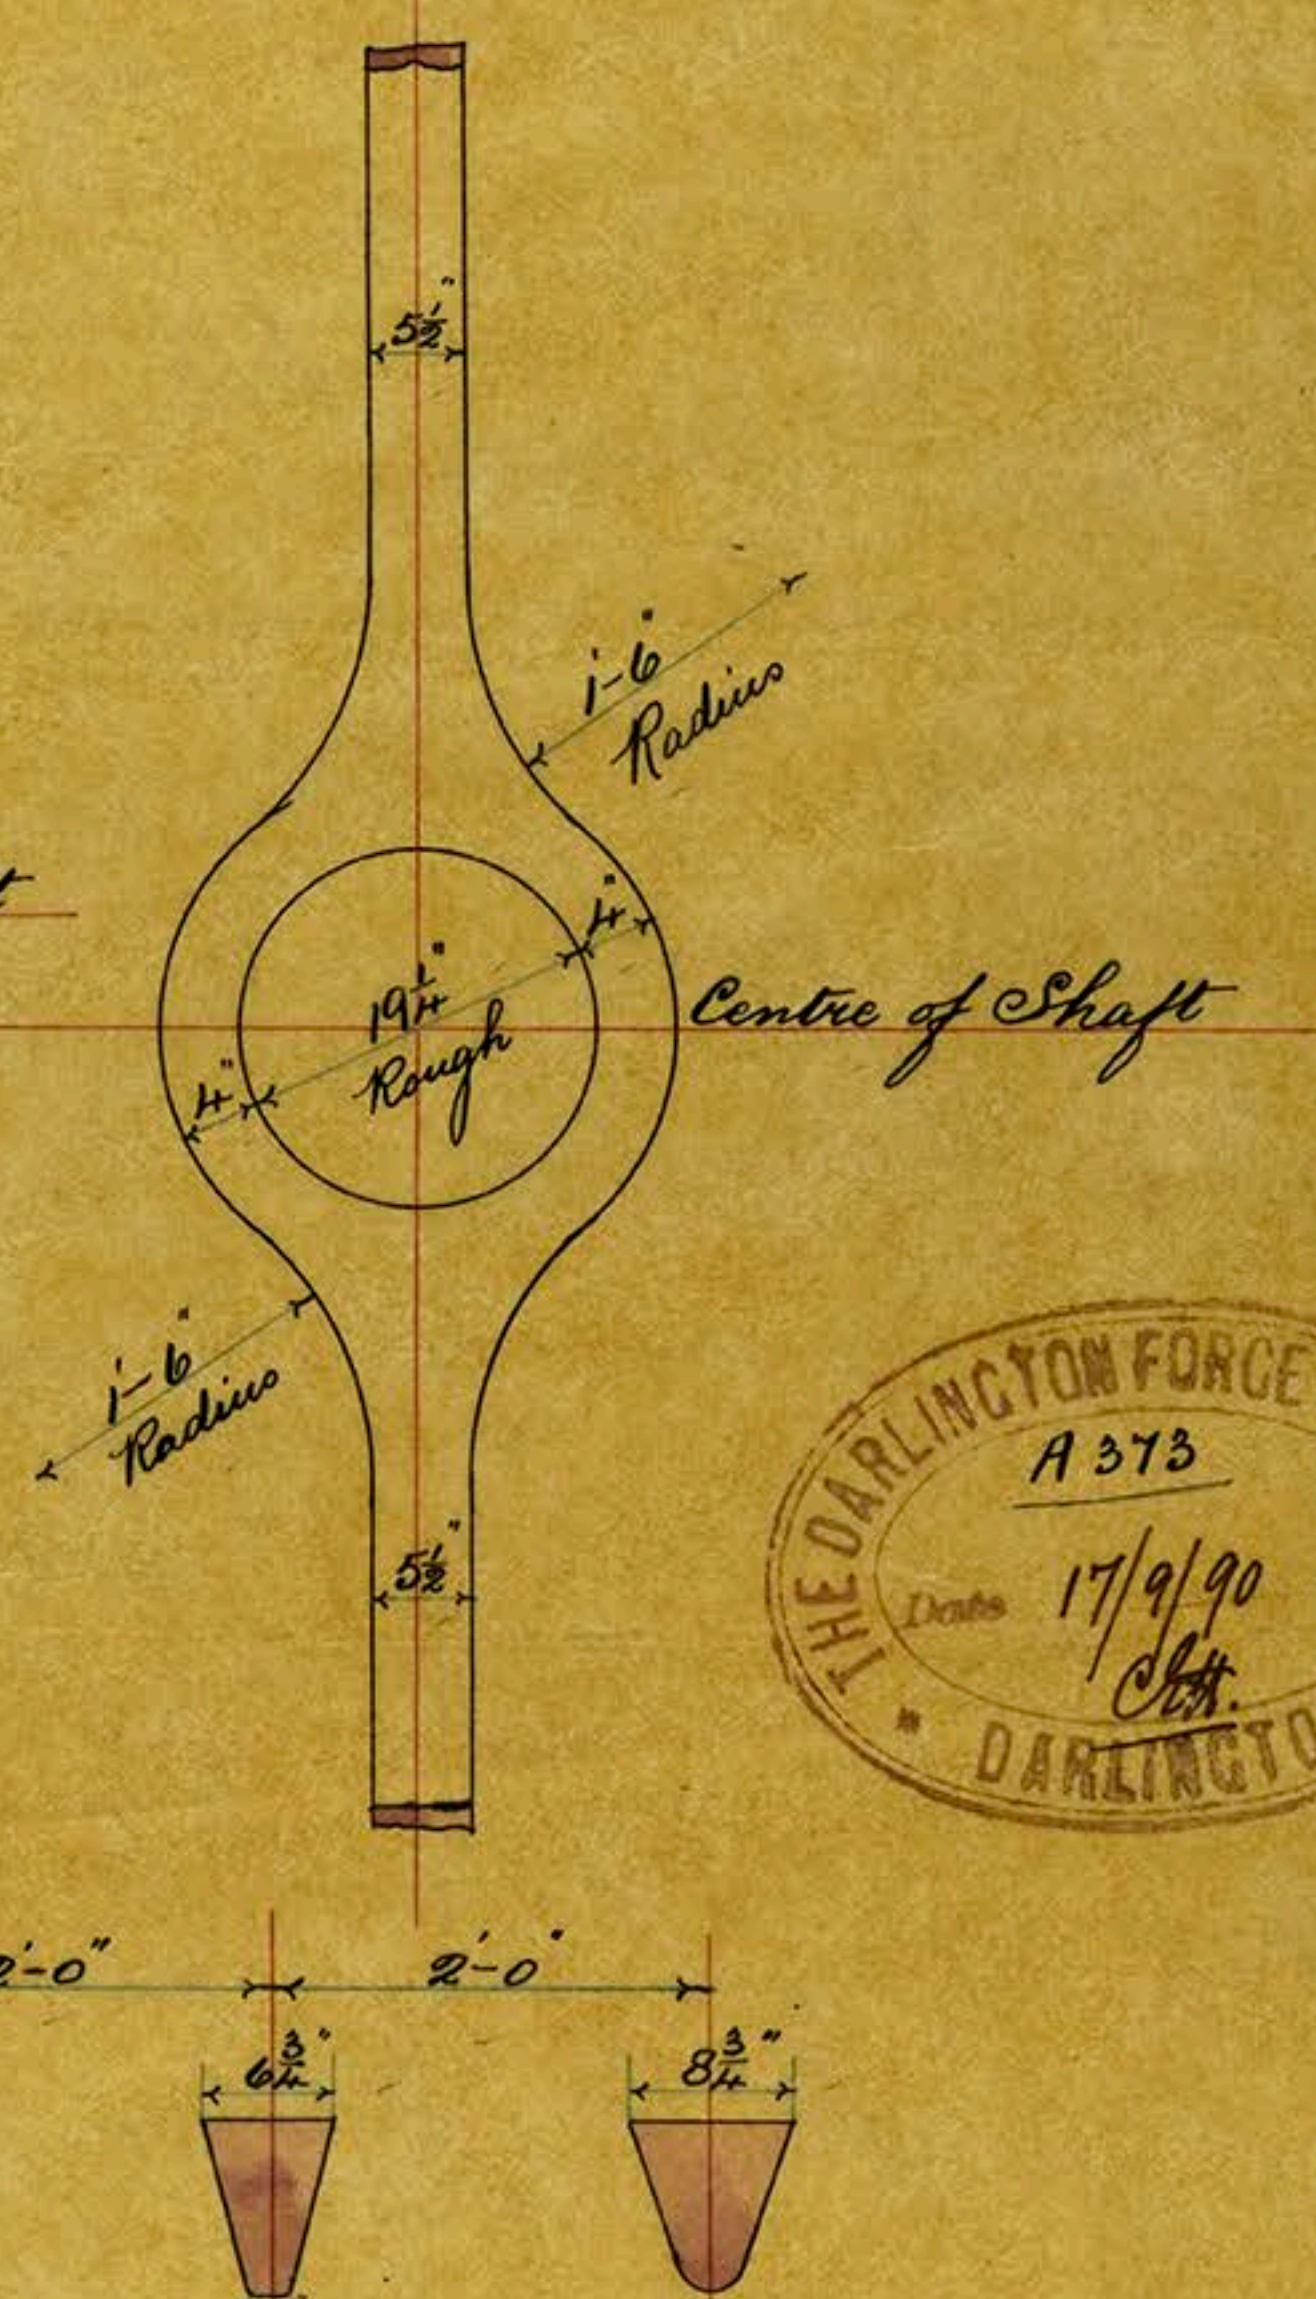


