

- DIMENSIONS -

LENGTH P. 283' 0"
 BREADTH A. 37' 0"
 DEPTH 20' 3"
 DEPTH OF HOLD TOP OF TANK 17' 6 3/4"
 DO DO DO FLOORS 19' 0 3/4"

- S. S. N° 25 -


- MIDSHIP SECTION -

SCALE 1/2 INCH = 1 FT

- NUMERALS -

1/2 BEAM 18' 5"
 1/2 GIRTH 36' 12"
 DEPTH 21' 12"
 75' 4" FRAME N°
 281.5 x 75.64 = 21.292 PLATING N°
 DEPTHS 13.39 PROPORTIONS
 BREADTHS 7.60
 EQUIPMENT N° 23.52.

SAT 19 AUG 90

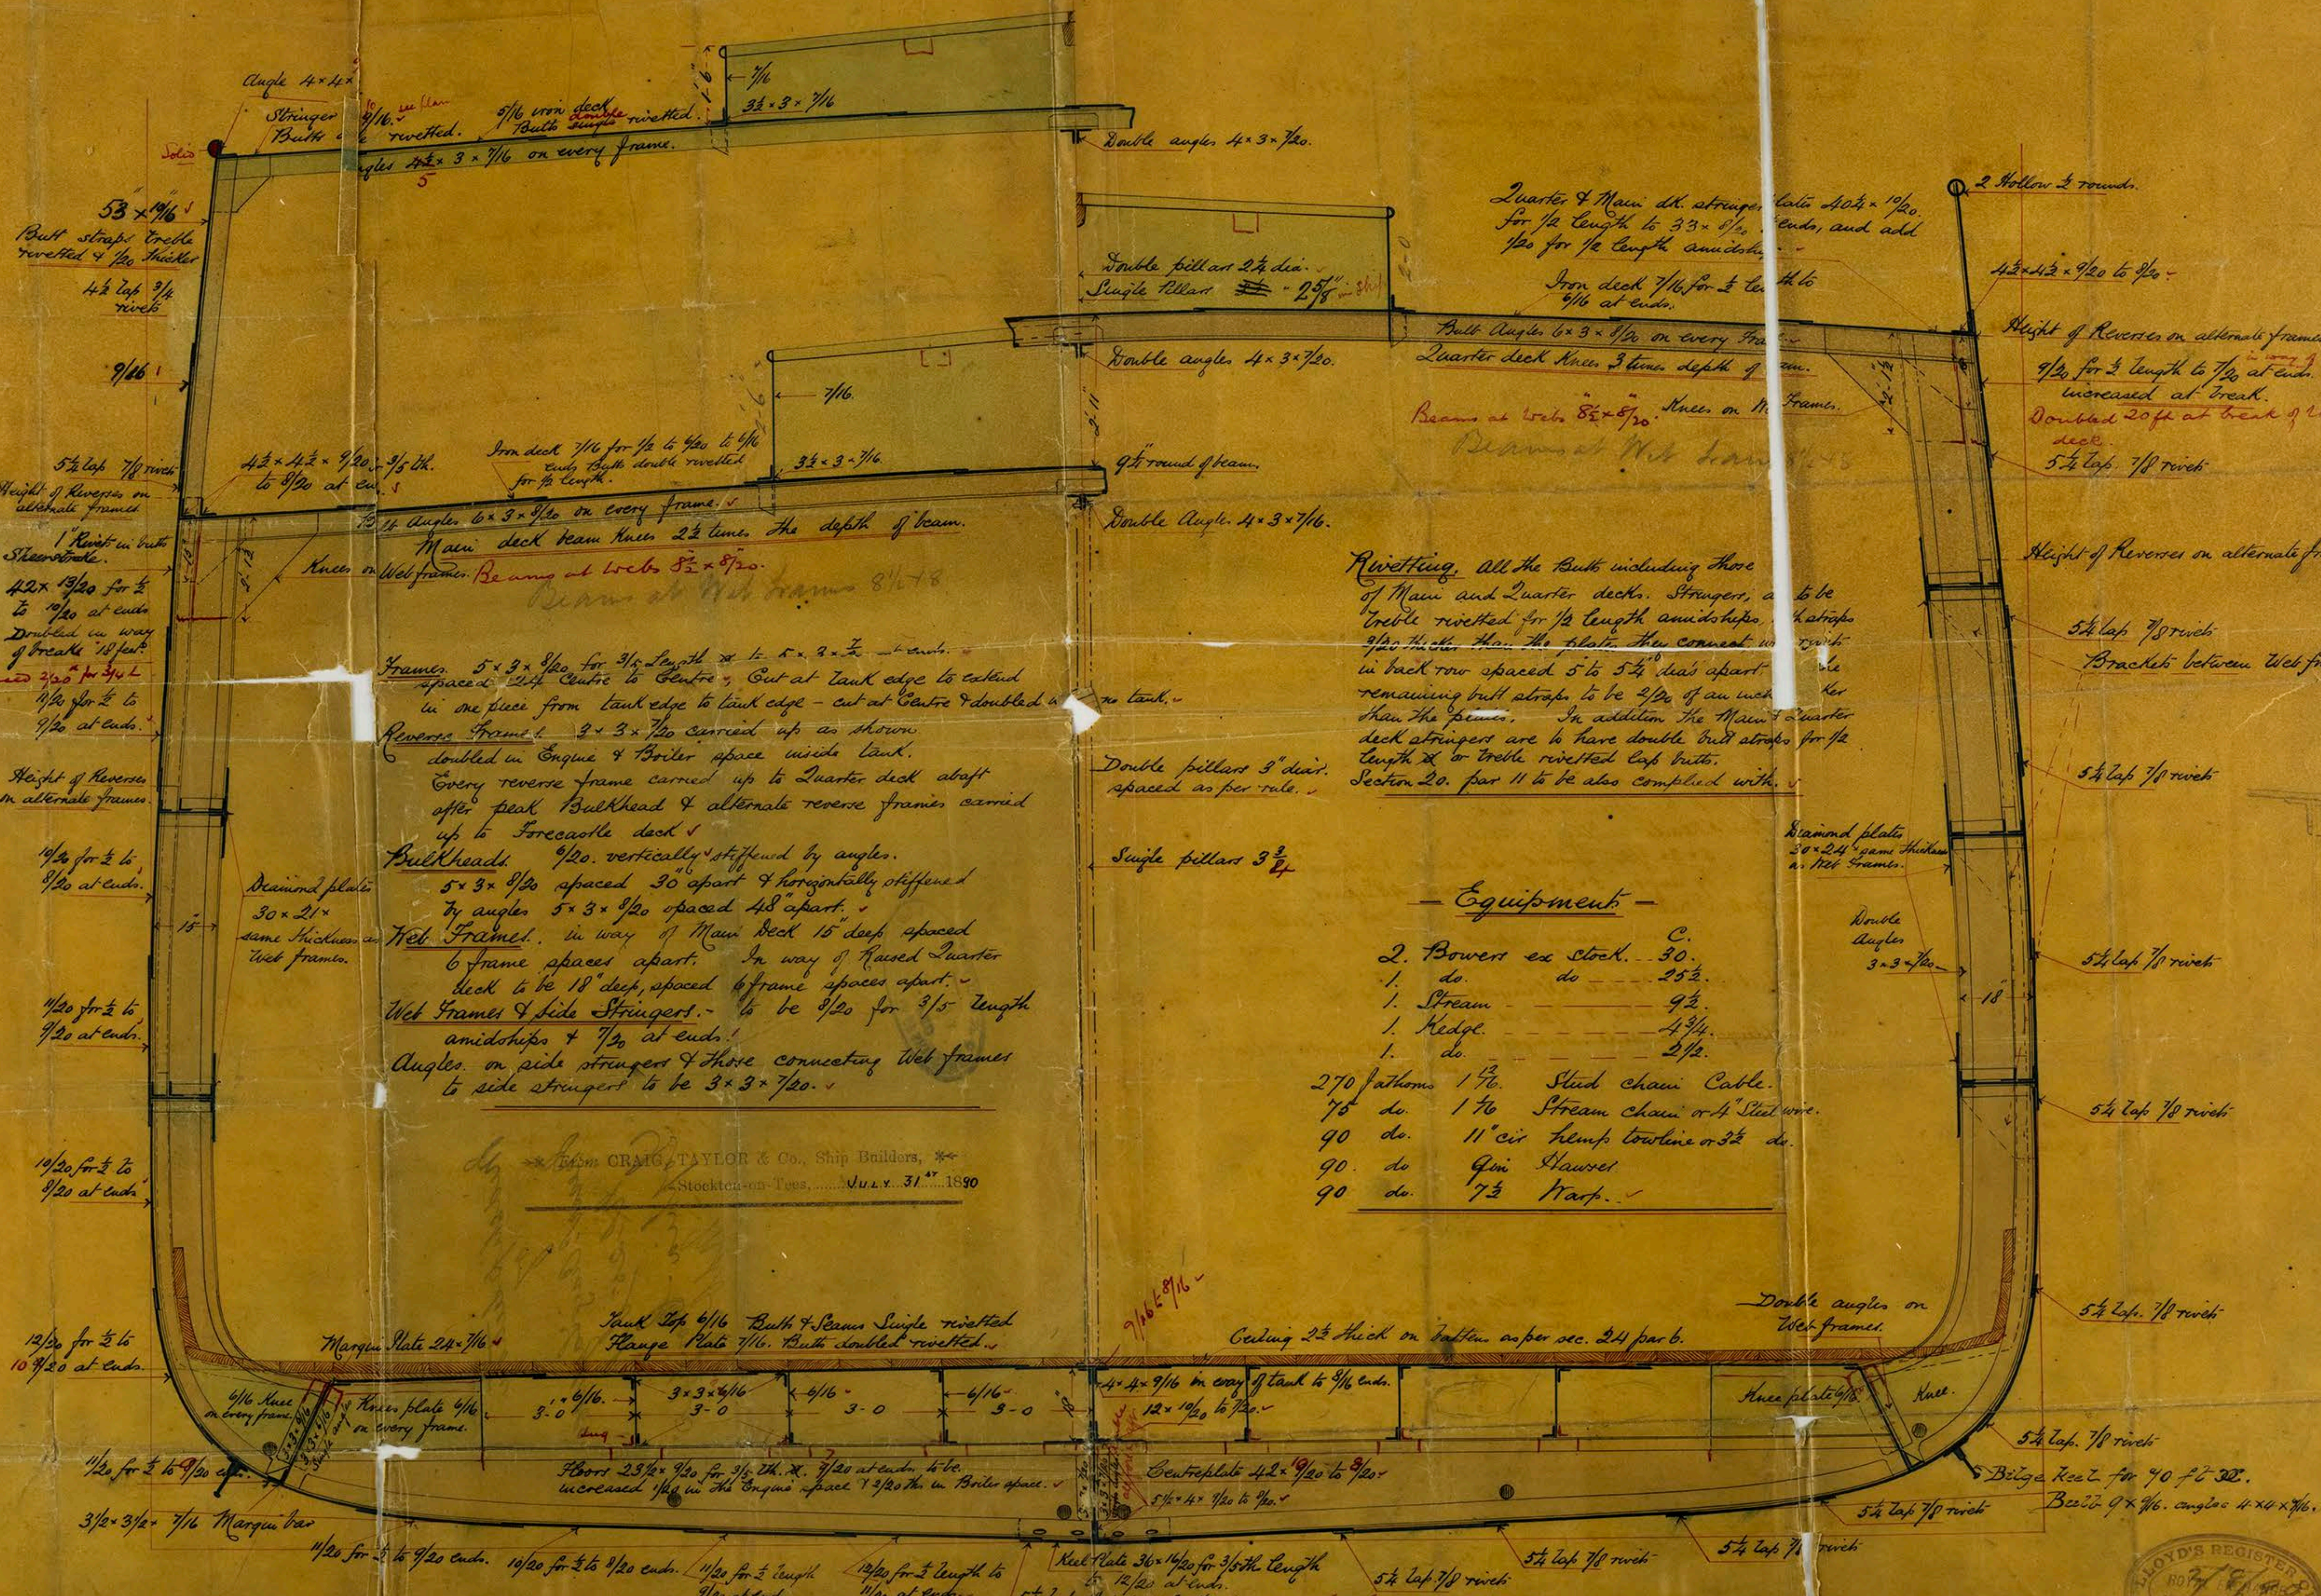


Riveting. All the Bulk including those of Main and Quarter decks. Stringers, & to be treble riveted for 1/2 length amidships. & straps 9/20 thicker than the plates. The connect in rivets in back row spaced 5 to 5 1/2' apart. The remaining butt straps to be 2/20 of an inch thicker than the plates. In addition the Main & Quarter deck stringers are to have double butt straps for 1/2 length & to treble riveted lap butts. Section 20. par 11 to be also complied with.

- Equipment -

2. Bowers ex Stock. 30.
 1. do do 25.
 1. Stream 9 1/2.
 1. Redol. 4 3/4.
 1. do 2 1/2.
 270 fathoms 1 1/2. Stud chain Cable.
 75 do 1 1/2. Stream chain or 4" Steel wire.
 90 do 11" cir hemp towline or 5 1/2" do.
 90 do Gun Hawser.
 90 do 7 1/2 Harp.

Note All outside plating, except the Garboard, and flat keel plating to be reduced 1/20 in way of tank web 1/20 and above.

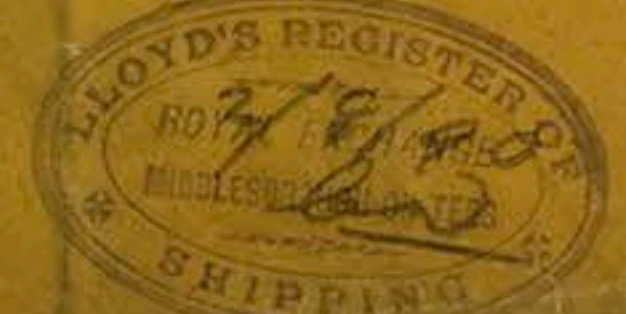


1/2 of Tracing 1339

Green Web Form

MDB 741A/75

Midshipman
of
Hess's Craig Layton
No 25
"Sophia-Corpus"
MDB 660

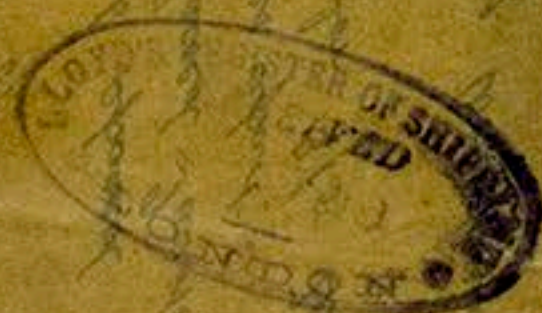

© 2018

Lloyd's Register
Foundation