

S.S. "Sophia Couppa" Received at Middlesbrough Office, 30th Jan 18 91

Lloyd's Register of British and Foreign Shipping.

(Report on Vessel No. 365 Port Moro)

Middlesbrough

No. 17594

SHIP FORGINGS OR CASTINGS.

I have to report that the undermentioned Iron ^{and} or Steel Forgings or Castings, manufactured by The Darlington Forge Co. & Stockton Forge Co. of Darlington & Stockton for the Vessel No. 25, being built by Messrs Craig Saylor & Co. of Stockton have been inspected by me as set forth below, and found to be, so far as can be seen, sound

The stern frame was tested in accordance with the rules and found satisfactory

Mark on Forgings.

Lloyd's

No. 17594



H.C.

Hugh Cameron

Darlington Forge Co., Stockton Forge Co. Sunderland

	STERN FRAME.	RUDDER FRAME.	STEM.
Material*	<u>Siemens steel</u>	<u>Scrap iron</u>	<u>Scrap iron</u>
How made	<u>Cast</u>	<u>Forged</u>	<u>Forged</u>
Dimensions	<u>as per drawing attached</u>	<u>7 1/4" - 3 1/2"</u>	<u>9' 2 1/2"</u>
Progress on Inspection	<u>Tested & finished</u>	<u>Smithed</u>	<u>Forged</u>
Dates when Inspected	<u>Sept 23-26 Oct 3-8/90</u>	<u>Jan 7-12-21/91</u>	<u>Oct 17/90</u>

SKETCHES OF FRAMES SHEWING POSITION AND DESCRIPTION OF WELDS OF FORGINGS, OR PARTICULARS OF TESTS APPLIED TO CASTINGS.

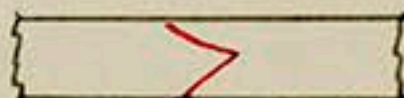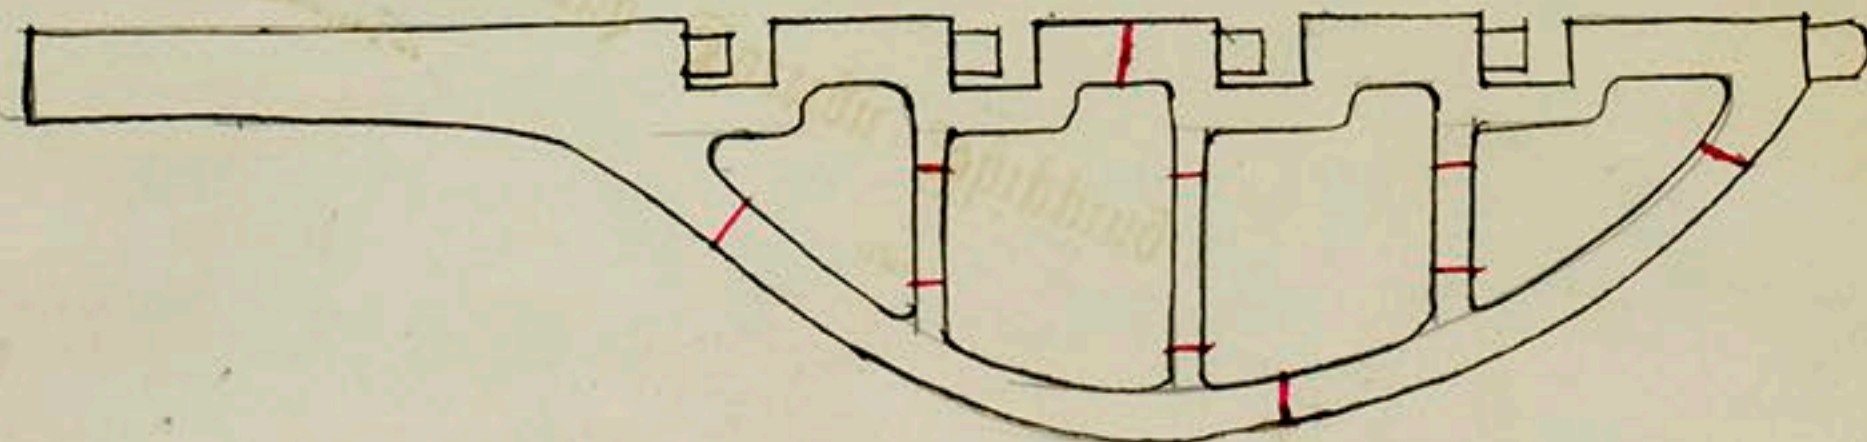

Welds

* If of Iron, state whether scrap or puddled Iron.