
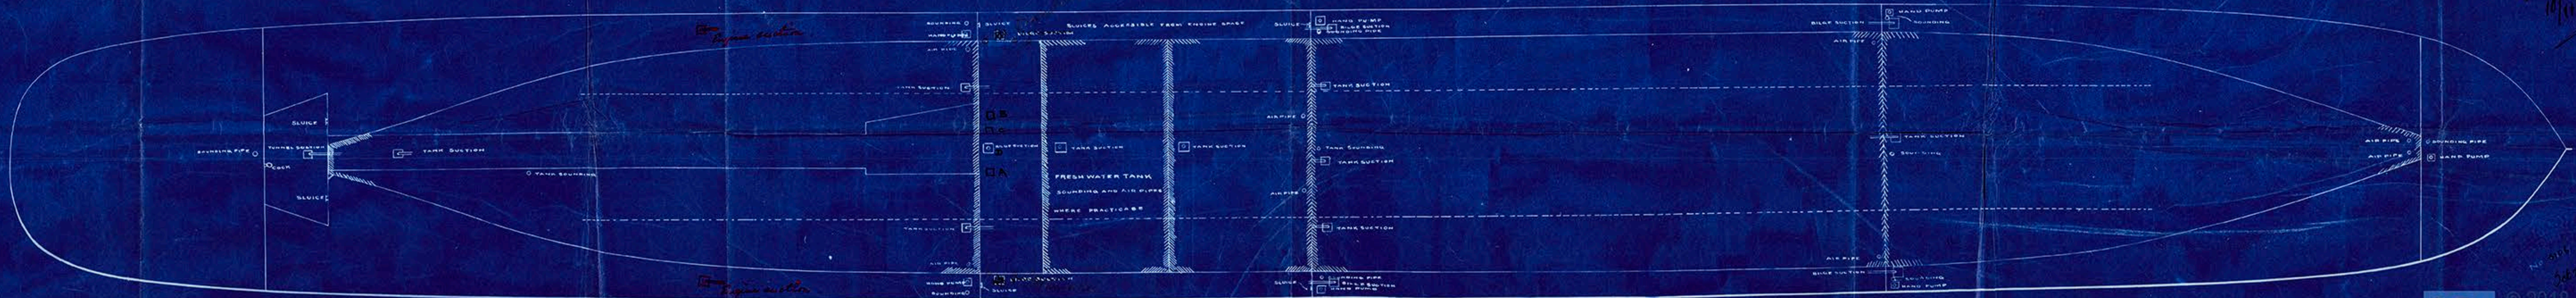


14. 10. 11. 90

# PUMPING ARRANGEMENT No 330 Scale 1/8 of an inch = 1 foot.

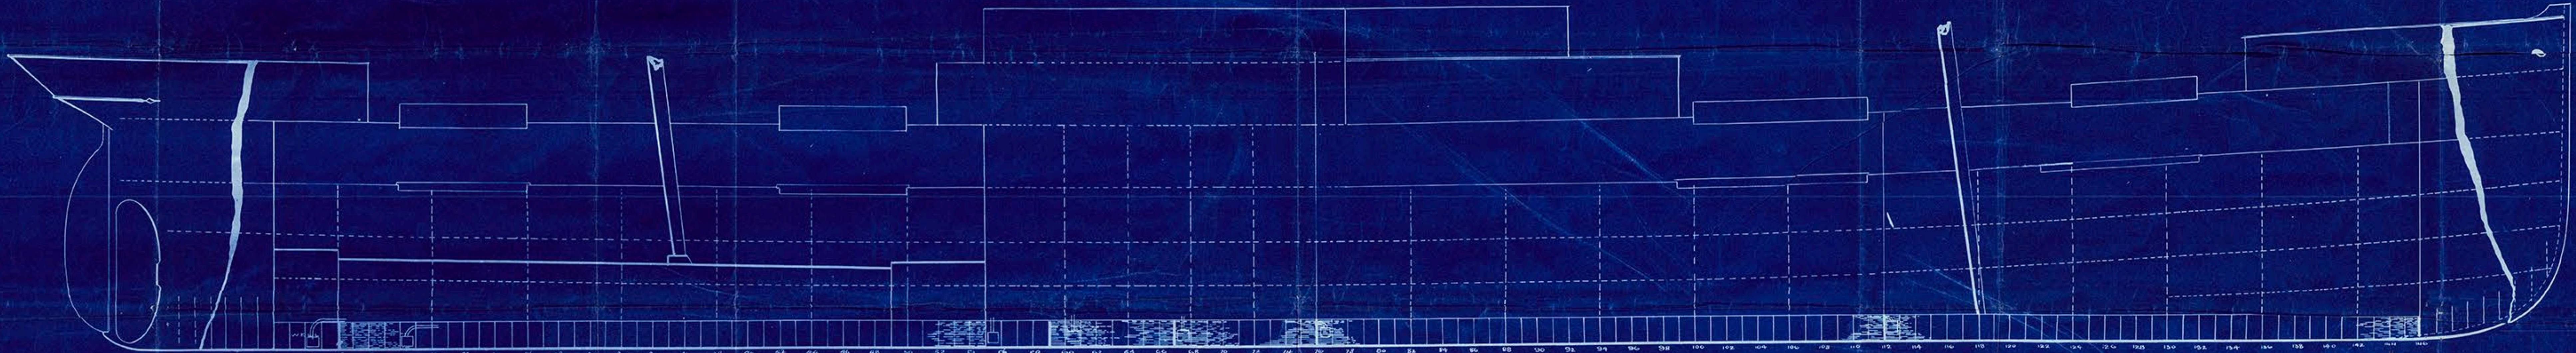

As per drawing of fuel tank  
 and other details of  
 the engine room

J. J. M.  
 17/11/90

No 330  
 17/11/90



R. Disconts  
Middlestrong

---

S.S. No 330 + 332  
Pumping plan ~~+ 339~~

---

No 330 S.S. Oil Rivers

No 332 S.S. Angola

Ind 481

---

31 Report No 340

32 " " 481

---



© 2018

Lloyd's Register  
Foundation