

SCALE 1/2 INCH TO ONE FOOT.

DIMENSIONS.

LENGTH OVER ALL..... 243.6 DEPTH @ HOLE..... 14.9
..... B.P..... 234.0..... MILED..... 17.1
BREADTH EX..... 34.6 CLASS A LLOYDS..... 100/A1

IRON IN 16^{THS} STEEL IN 20^{THS}

QUARTER DECK RULE

EQUIPMENT.

[illegible]

NUMERALS


$\frac{1}{2}$ GIRTH.. 31.93
 $\frac{1}{2}$ BREADTH 17.16
 DEPTH..... 17.79
 66.78
 232.66
 40063
 40063
 13356
 20034
 13356
 15537.0348

PROPORTIONS.

DEPTH TO LENGTH 13.07
BREADTHS 6.74.

EQUIPMENT NO 16956-10

IRON IN 16^{THS} STEEL IN 20^{THS}

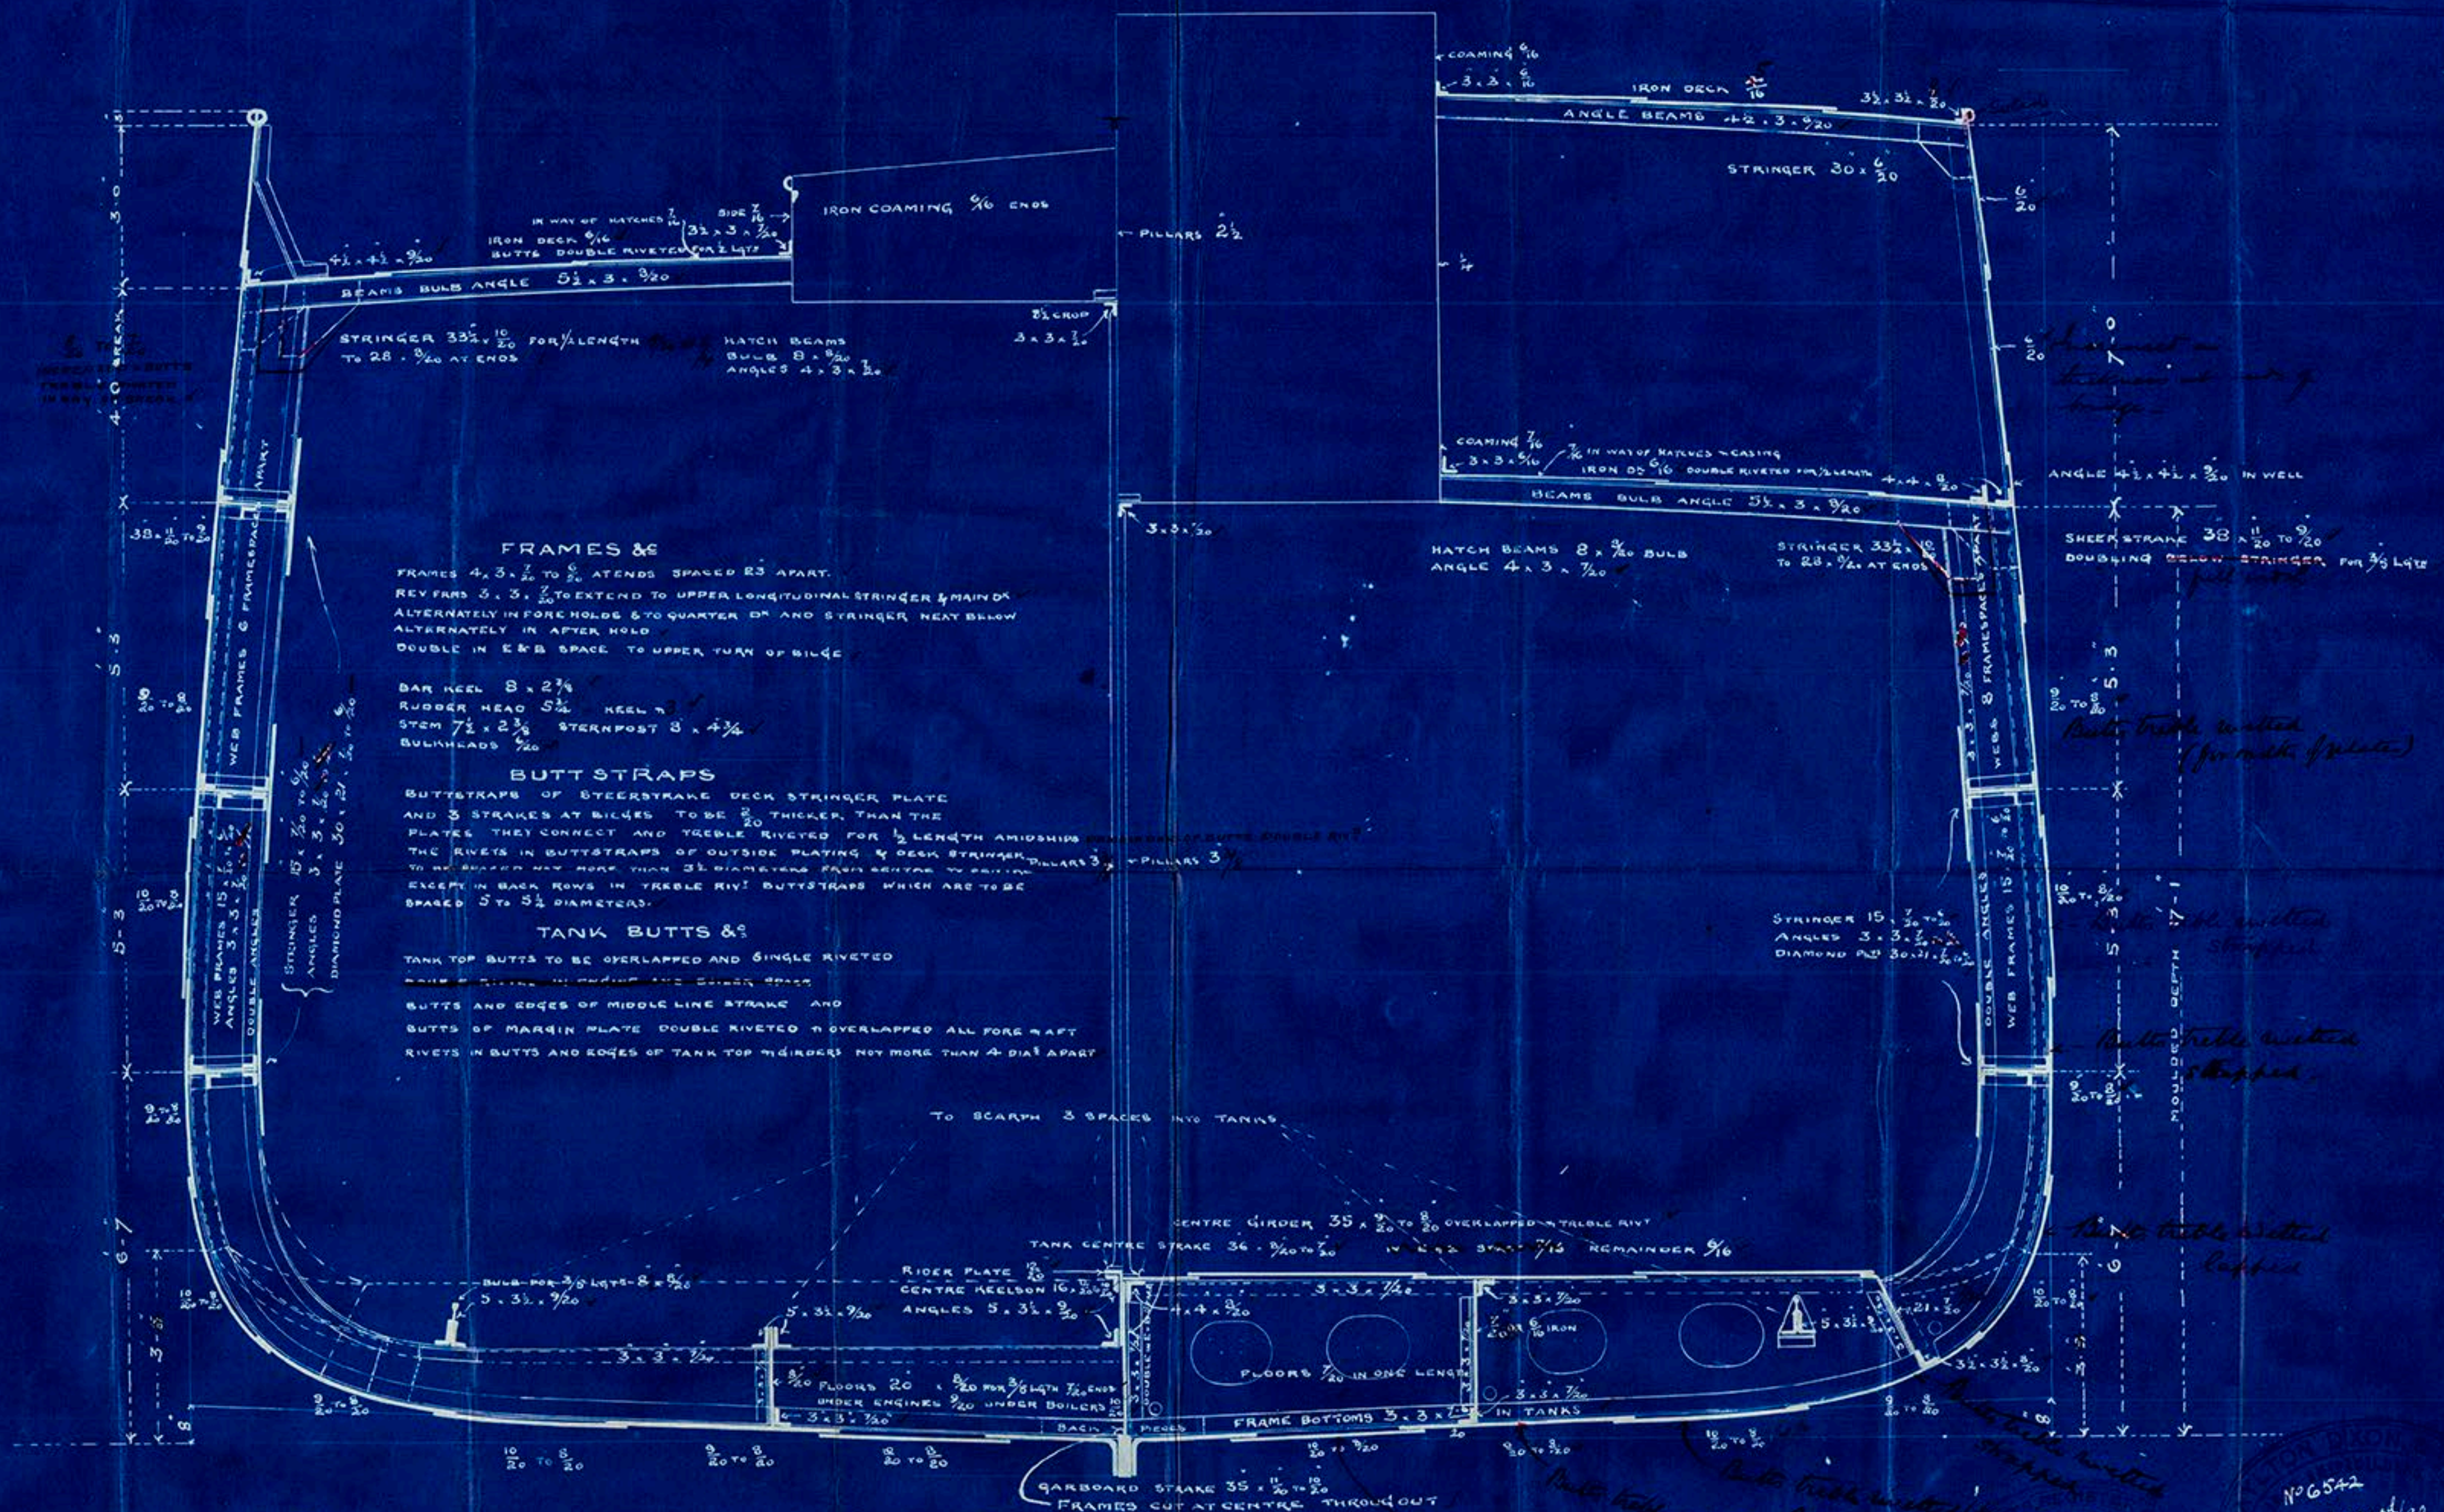

N° 336

No 6542
Sept 22nd / 90

Lloyd's Register
Foundation



R. Dixon & Co
Middlesbrough

S.S. No 336

Midship Section

S.S. "Grear"

Rep. No 390



Led 15990



© 2018

Lloyd's Register
Foundation

MDB741A/152