

of Apikander

Received at Middlesbrough Office, 18th Dec^r 1891

Lloyd's Register of British and Foreign Shipping.

Middlesbrough (Report on Vessel No. 643 Port Mbrro.)

No. 2162a SHIP FORGINGS OR CASTINGS.

I have to report that the undermentioned Iron or Steel Forgings or Castings, manufactured by
The Darlington Forge Co of Darlington
for the Vessel No. 361, being built by Messrs R Dixon Co.
of Middlesbrough have been inspected by me as set forth below, and found
to be, so far as can be seen, sound.

Mark on Forgings.


Lloyd's
No. 2162a
No. 6

Walter Cameron
Sunderland.

17. 12. 91

	STERN FRAME.	RUDDER FRAME.	STEM.
Material*	Scrap iron	Scrap iron	}
How made	Forged	Forged	
Dimensions	10' 4 1/2'	8' 4"	
Progress on Inspection	Forged Smithers	Forged Smithers	
Dates when Inspected	Oct 1-6-22 Nov 9/91	Nov 18-24 Dec 11-15/91	

SKETCHES OF FRAMES SHEWING POSITION AND DESCRIPTION OF WELDS OF FORGINGS, OR PARTICULARS OF TESTS APPLIED TO CASTINGS.

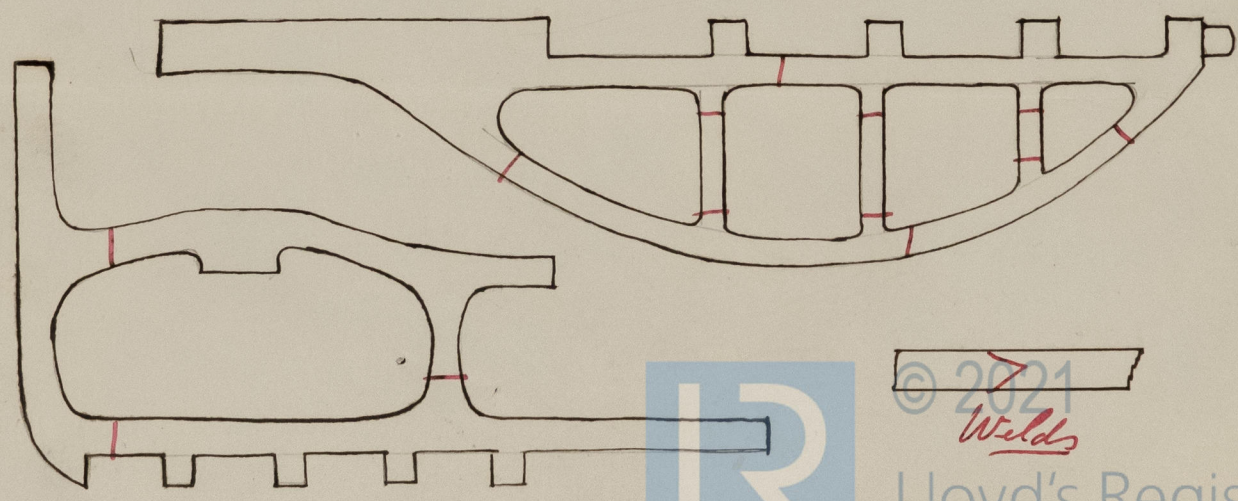

© 2021
Welds

Lloyd's Register
Foundation