

of Kaffir

Received at Middlesboro Office, 18th Dec^r 1891

Lloyd's Register of British and Foreign Shipping.

Middlesboro

(Report on Vessel No. 412 Port Mboro)

No. 2114 a. SHIP FORGINGS OR CASTINGS.

I have to report that the undermentioned Iron or ~~Steel~~ Forgings or Castings, manufactured by The Darlington Forge Co. of Darlington for the Vessel No. 366, being built by Mess^{rs} R Dixon & Co of Middlesboro have been inspected by me as set forth below, and found to be, so far as can be seen, sound

The words FORGINGS or CASTINGS, IRON or STEEL, should be struck out as may be required.

Mark on Forgings.


Lloyd's

No. 2114 a
16.6

Wm Cameron
Sinduland.
17.12.91

	STERN FRAME.	RUDDER FRAME.	STEM.
Material*	<u>Scrap iron</u>	<u>Scrap iron</u>	
How made	<u>Faged</u>	<u>Faged</u>	
Dimensions	<u>10" x 6"</u>	<u>8" x 4"</u>	
Progress on Inspection	<u>Finished</u>	<u>Finished</u>	
Dates when Inspected	<u>Sept 9-25 Oct 14-16/91</u>	<u>Oct 14-16 Nov 20-24/91</u>	

SKETCHES OF FRAMES SHEWING POSITION AND DESCRIPTION OF WELDS OF FORGINGS, OR PARTICULARS OF TESTS APPLIED TO CASTINGS.

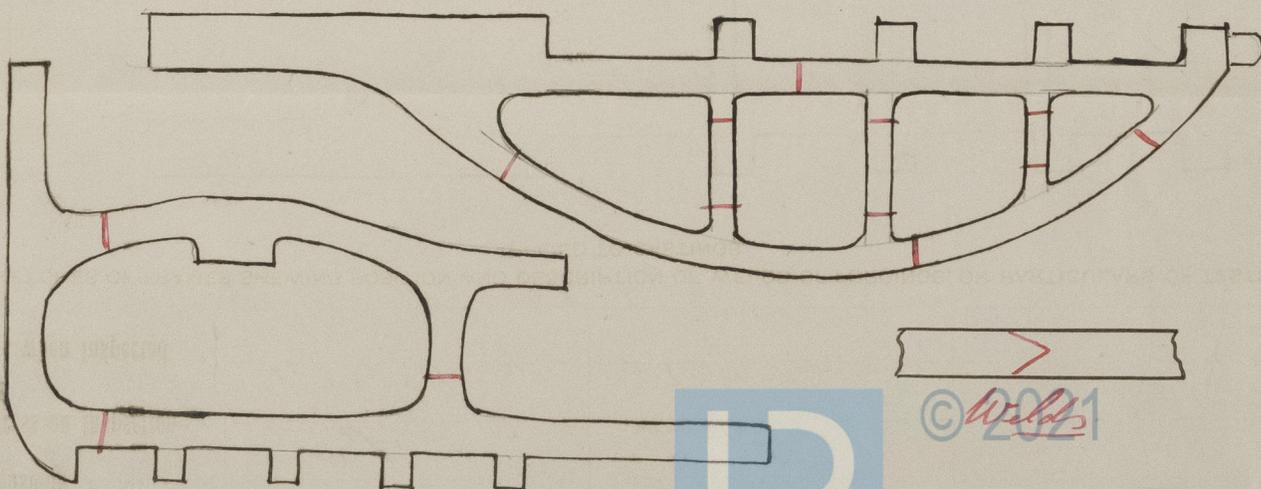

© Welds 2021

Lloyd's Register
Foundation

* If of Iron, state whether scrap or puddled Iron.