


# PROFILE

LENGTH OVERALL 322' 6" DEPTH TO TANK TOP 25' 6"  
LENGTH B.P 308' 1" DEPTH MOULDED 28' 0"  
BREADTH (EXT) 40' 6" CLASS AT LLOYDS 100 A

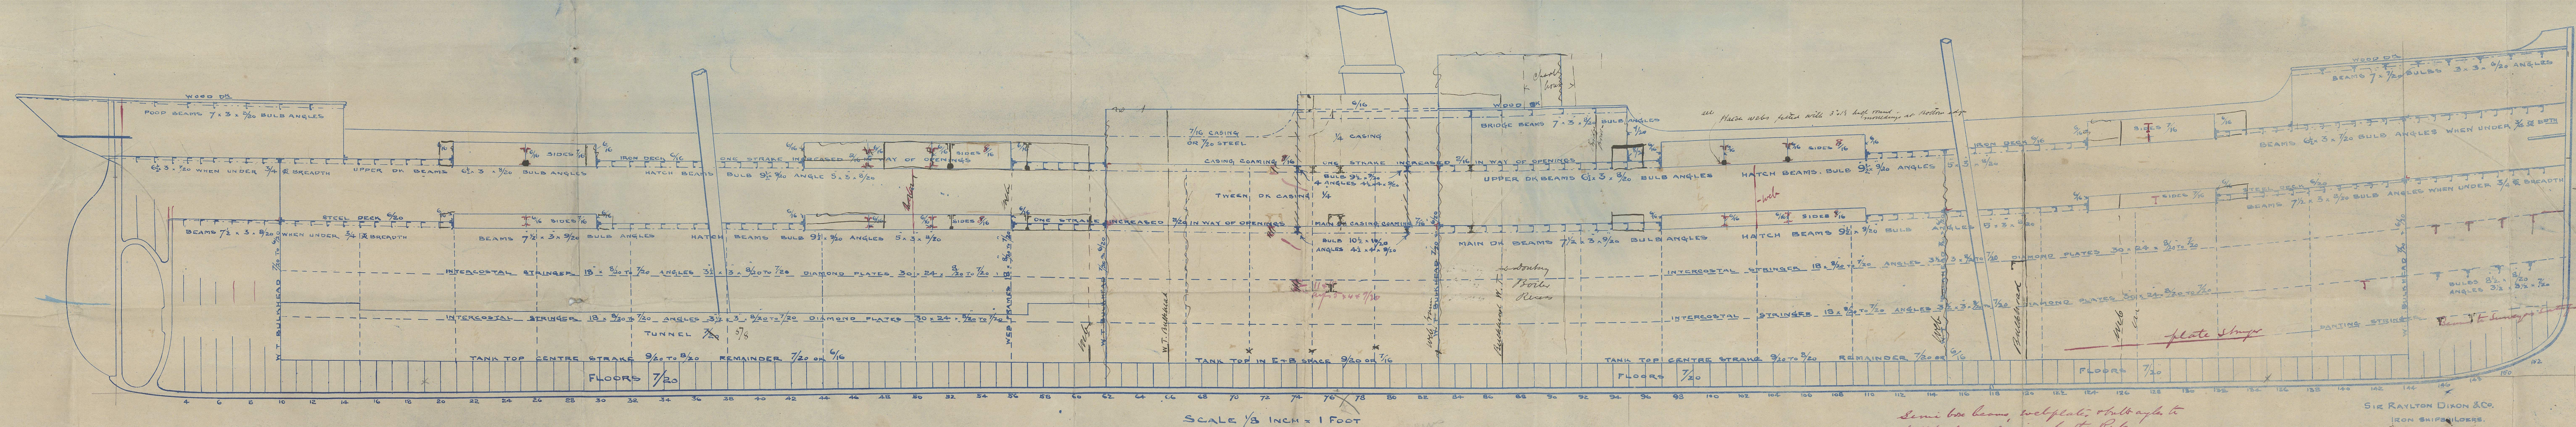

N°360: 361: 362 & 363

← 16.9.91 →

SIR RAYLTON DIXON & CO.  
IRON SHIPBUILDERS.  
CLEVELAND DOCKYARD.  
MIDDLESBROUGH-TEES


3358  
DATE Aug 12

13/8/5

© 2021  
1DB745 0004, 2  
Lloyd's Register  
Foundation



44  
To be returned when done with

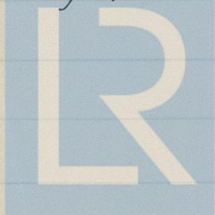


© 2021  
Lloyd's Register  
Foundation

MD3745-0004½

R. Disentle.  
Middlesbrough

SS. No 360  
Span deck

360. S. S. Kaffir " Report No 712.

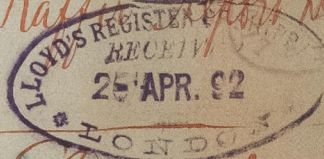


Elevation.

Report No 712

No 361. 1/2 'Afrikander' Report No 673

No 362. 1/2 'Transvaal' " "

No 363. 1/2 'Zulu' " " 704

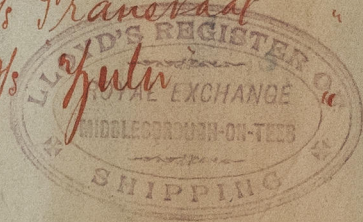

© 2021

Lloyd's Register  
Foundation

MD13745-0004