


16.3.92

Section
Scale $\frac{1}{2}$ " = one foot

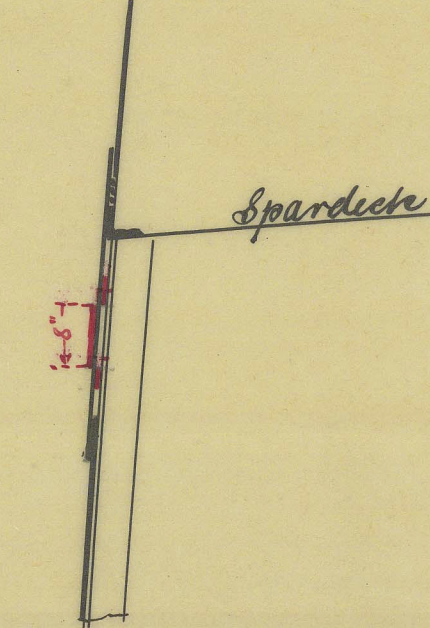


Plan showing Sidlights in Twin Deck

S.S. "Afrikander" & Co

Scale $\frac{1}{4}$ " = one foot


Received
17 MAR

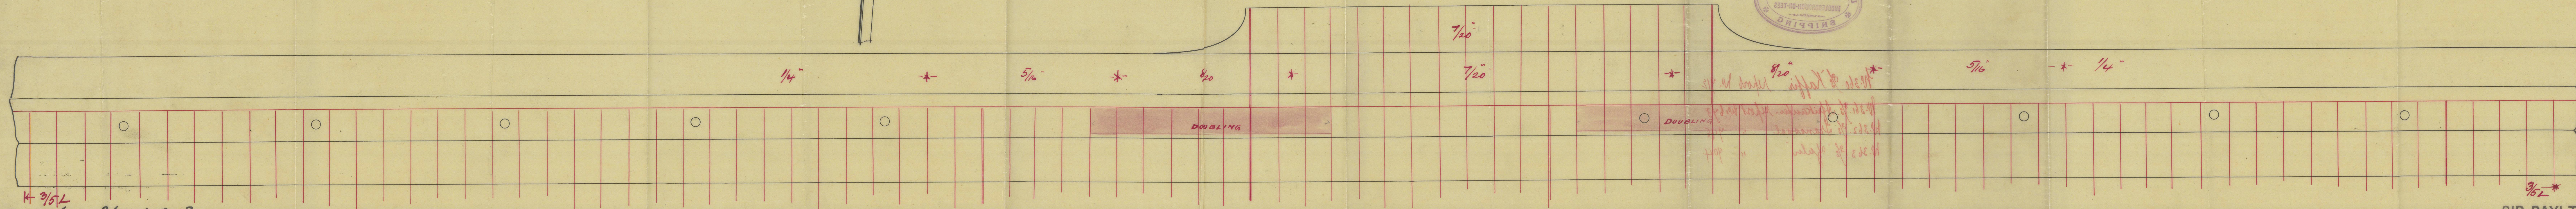

16.3.92
S.S. 360-1-2-3

SIR RAYLTON DIXON & Co.,
IRON SHIP BUILDERS,
CLEVELAND DOCK YARDS,
MIDDLESBROUGH-ON-TEES.

Lloyd's Register
Foundation

Air Raylins Dixon & Co
 Question of
 Compensation for cutting out
 in the shares of

N^o 360,1.243.

Spardick

Received.
 27 MAR



212

1/4

-*

as

N^o 360. % Kaffis report no. 412

N^o 361. % Afrikaander. report no. 673

N^o 362. % Transvaal. " 705

N^o 363. % Zulul. " 704



© 2021

Lloyd's Register
 Foundation

MD3745 0006