

Received at Middlesboro Office, 27th Nov^r 1895

Lloyd's Register of British and Foreign Shipping.

(Report on Vessel No. _____ Port Inbro)
Middlesboro

No. 3104.a. SHIP FORGINGS OR CASTINGS.

I have to report that the undermentioned Iron or ~~Steel~~ Forgings or Castings, manufactured by The Darlington Forge Co. of Darlington for the Vessel No. 416, being built by Messrs R Dixon & Co. of Middlesboro have been inspected by me as set forth below, and found to be, so far as can be seen, sound.

The words FORGINGS or CASTINGS, IRON or STEEL, should be struck out as may be required.

Mark on Forgings.


Lloyd's
No. 3104a
No. 6.

Wm R Cameron
Sunderland

26-11-95

	STERN FRAME.	RUDDER FRAME.	STEM.
Material*	<u>Scrap iron</u>	<u>Scrap iron</u>	<u>Scrap iron</u>
How made	<u>Forged</u>	<u>Forged</u>	<u>Forged</u>
Dimensions	<u>10 x 6"</u>	<u>8-4"</u>	<u>10 x 2 5/8"</u>
Progress on Inspection	<u>Forged & smithed</u>	<u>Forged & smithed</u>	<u>Forged</u>
Date when Inspected	<u>Aug 11th to Sept 6/95</u>	<u>Sept 12th to Oct 10/95</u>	<u>Sept 3/95</u>

SKETCHES OF FRAMES SHOWING POSITION AND DESCRIPTION OF WELDS OF FORGINGS, OR PARTICULARS OF TESTS APPLIED TO CASTINGS.

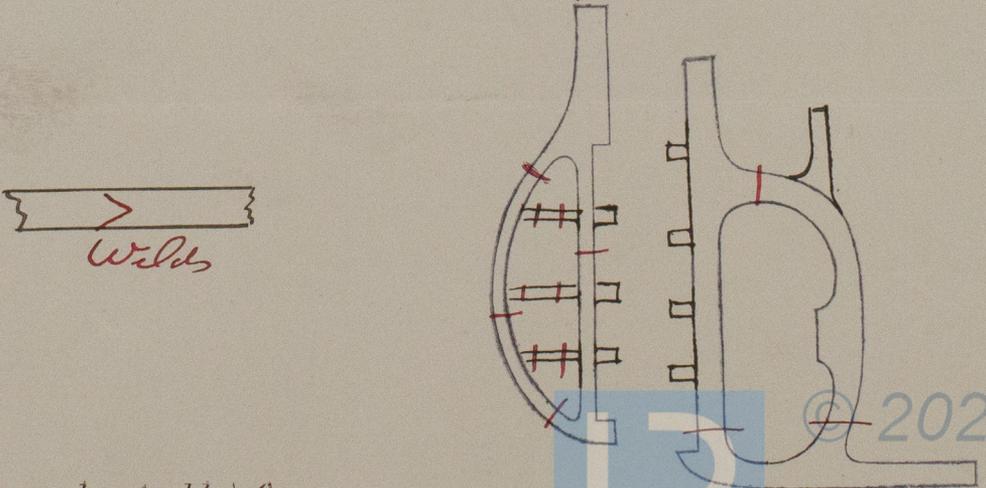

Fee (if any chargeable) £ : :

To be paid at _____

* If of Iron, state whether scrap or puddled Iron.

Mr Raylton Dixon & Co:

No 416.

Ships Joining

S.S. Sea King.

Ambro report No. 1668



© 2020

Lloyd's Register
Foundation